


WELL PLUGGING RECORD

Give All Information Completely
Make Required Affidavit
Mail or Deliver Report to:
Conservation Division
State Corporation Commission
800 Bittling Building
Wichita, Kansas

Russell County, Sec. 17 Twp. 15 Rge. 12 (W) ~~11~~

Location as "NE/CNW $\frac{1}{4}$ SW $\frac{1}{4}$ " or footage from lines SW SE SW
Lease Owner Fred Anschutz
Lease Name Anschutz Well No. 1
Office Address Box 615 Hays, Ks.
Character of Well (completed as Oil, Gas or Dry Hole) Dry Hole

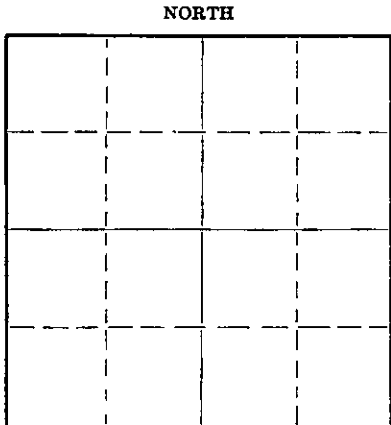

Locate well correctly on above Section Plat

Date well completed 9-5-48 19
Application for plugging filed 1-10-49 19
Application for plugging approved 1-10-49 19
Plugging commenced 1-4-49 19
Plugging completed 1-4-49 19
Reason for abandonment of well or producing formation Dry Hole

If a producing well is abandoned, date of last production Dry Hole 19
Was permission obtained from the Conservation Division or its agents before plugging was commenced? Yes
Name of Conservation Agent who supervised plugging of this well Eldon Petty
Producing formation Depth to top Bottom Total Depth of Well 3327 Feet
Show depth and thickness of all water, oil and gas formations.

OIL, GAS OR WATER RECORDS

CASING RECORD

Formation	Content	From	To	Size	Put In	Pulled Out

Describe in detail the manner in which the well was plugged, indicating where the mud fluid was placed and the method or methods used in introducing it into the hole. If cement or other plugs were used, state the character of same and depth placed, from feet to feet for each plug set.

8-5/8" @ 230, circulated with cement.
5-1/2" @ 3315', lane wells plugs to 3078'.
Perf. @ 3040'. Heavy mud 3040' to 3025' and 5 sacks cement. 5-1/2" ripped and pulled.
Heavy mud to 230'. Wood plug, rock and 15 sacks cement. Heavy mud to 30'. Wood plug, rock and 10 sacks cement.

(If additional description is necessary, use BACK of this sheet)

Correspondence regarding this well should be addressed to F. B. Anschutz
Address Box 615 Hays, Ks.

STATE OF Kansas, COUNTY OF Sedgwick, ss.

(employee of owner) or (owner or operator) of the above-described well, being first duly sworn on oath, says: That I have knowledge of the facts, statements, and matters herein contained and the log of the above-described well as filed and that the same are true and correct. So help me God

(Signature) Fred B. Anschutz


Box 615 Hays, Ks. (Address)

SUBSCRIBED AND SWORN to before me this 8th day of March, 1949

Seward S. Greiler Notary Public.

My commission expires January 31, 1953

22-5133-s 9-48-10M

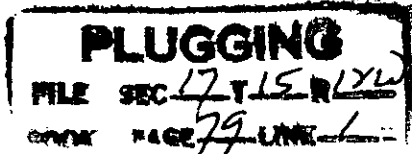

Conservation Div. 03-08-49 MAR 8 1949 REND

STATE CORPORATION COMMISSION

Anschutz #1

SW SE SW Section 17-15-12

Russell County, Kansas

Fred B. Anschutz, et al.

Commenced: August 24, 1948
Completed: September 5, 1948

Sand and surface soil	0	120
Shale and shells	120	255
Shale and shells	255	475
Sand, shale and shells	475	730
Shale and shells	730	795
Anhydrite	795	815
Shale and shells	815	1010
Shale and shells	1010	1435
Shale and shells	1435	1535
Lime and shale	1535	1585
Shale and lime	1585	1755
Lime and shale	1755	1860
Lime and shale	1860	1925
Lime and shale	1925	2000
Shale	2000	2150
Shale and shells	2150	2260
Shale and lime	2260	2360
Shale	2360	2460
Shale and shells	2460	2535
Shale and shells	2535	2625
Lime and shale	2625	2690
Lime and shale	2690	2760
Lime and shale	2760	2815
Lime and shale	2815	2860
Lime and shale	2860	2915
Lime and shale	2915	2945
Lime and shale	2945	3035
Lime	3035	3090
Lime and shale	3090	3140
Lime and shale	3140	3170
Lime	3170	3215
Lime	3215	3265
Lime	3265	3300
Conglomerate	3300	3306
Arbuckle	3306	3310

RECORDED
 JAN 4 5 1949
 STATE CORPORATION
 COMMISSION
 KANSAS

CASING RECORD

8-5/8" casing set at 255' and cemented with 125 sacks cement.
5-1/2" casing set at 3308' and cemented with 75 sacks cement.

STATE OF KANSAS

SS:

COUNTY OF ELLIS

I hereby affirm that the above and foregoing is a true and correct copy of the log of your Anschutz #1 Well located in the SW SE SW of Section 17-15-12, Russell County, Kansas.

A-B-W DRILLING COMPANY, INC.

By Paul W. [Signature]

Subscribed and sworn to before me, a Notary Public, this 8th day of September, 1948.

Mildred M. Bower
Notary Public

My commission expires May 26, 1952.

PLUGGING
 FILE SEC 17-15-12
 BOOK PAGE 79 LINE 1