


WELL PLUGGING RECORD

Give All Information Completely  
Make Required Affidavit  
Mail or Deliver Report to:  
Conservation Division  
State Corporation Commission  
211 No. Broadway  
Wichita, Kansas

Russell County, Sec. 17 Twp. 15 Rge. (E) 12 (W)

Location as "NE/CNW/SW" or footage from lines NE NE SW  
Lease Owner Glickman Oil Company  
Lease Name Anschutz Well No. 1  
Office Address P. O. Box 3104, Wichita, Kansas  
Character of Well (completed as Oil, Gas or Dry Hole) Dry Hole  
Date well completed April 30, 19 63  
Application for plugging filed April 30, 19 63  
Application for plugging approved April 30, 19 63  
Plugging commenced April 30, 19 63  
Plugging completed April 30, 19 63  
Reason for abandonment of well or producing formation \_\_\_\_\_

NORTH

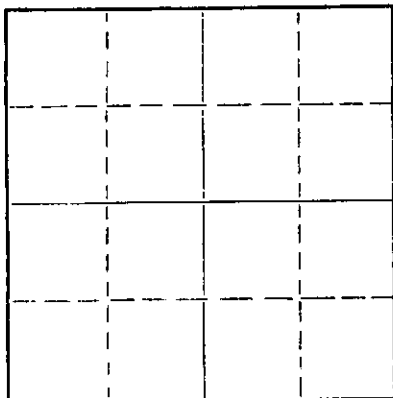

Locate well correctly on above  
Section Plat

If a producing well is abandoned, date of last production 19  
Was permission obtained from the Conservation Division or its agents before plugging was commenced? yes

Name of Conservation Agent who supervised plugging of this well Don Truan  
Producing formation \_\_\_\_\_ Depth to top \_\_\_\_\_ Bottom \_\_\_\_\_ Total Depth of Well 3338 Feet  
Show depth and thickness of all water, oil and gas formations.

OIL, GAS OR WATER RECORDS

CASING RECORD

FORMATION	CONTENT	FROM	TO	SIZE	PUT IN	PULLED OUT
				8-5/8	244	none

Describe in detail the manner in which the well was plugged, indicating where the mud fluid was placed and the method or methods used in introducing it into the hole. If cement or other plugs were used, state the character of same and depth placed, from \_\_\_\_\_ feet to \_\_\_\_\_ feet for each plug set.

Cemented through drill pipe w/25 sxs. @ 450'. Filled hole to 235' and cemented w/plug hulls and 20 sxs. Filled hole to 40'. Set Plug and hulls. Cemented w/11 sxs. & 4 sxs. in flat hole.

Wichita, Kansas

CONSERVATION DIVISION

MAY 16 1963

STATE CORPORATION COMMISSION

RECEIVED

(If additional description is necessary, use BACK of this sheet)

Name of Plugging Contractor Glickman Oil Company  
Address P. O. Box 3104, Wichita, Kansas

STATE OF Kansas, COUNTY OF Sedgwick ss.  
Milton Glickman (employee of owner) or (owner or operator) of the above-described well, being first duly sworn on oath, says: That I have knowledge of the facts, statements, and matters herein contained and the log of the above-described well as filed and that the same are true and correct. So help me God.  
(Signature) [Signature]

P. O. Box 3104, Wichita, Kansas  
(Address)

SUBSCRIBED AND SWORN TO before me this 7th day of May, 1963

[Signature]  
Notary Public.

My commission expires November 19, 1963



