STATE OF KANSAS
STATE CORPORATION COMMISSION
200 Colorado Derby Bldg.
Wichita, Kansas 67202

Form CP-4
Rev. 12-15-80

WELL PLUGGING RECORD

Give All Information Completely
Make Required Affidavit

15-077-20991-00-00

COUNTY HARPER SEC. 2 TWP. 33S RGE. 5 XE/W
Location as in quarters or footage from lines:
SW NW NE

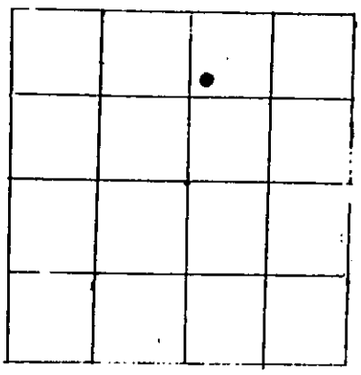

Locate Well correctly on above Section Platt.

Lease Owner POWDERHORN PETROLEUM, INC.
Lease Name Hilliard Well No. 1
Office Address 910 Sixteenth Street, Suite 510, Denver, CO 80202
Character of Well (Completed as Oil, Gas or Dry Hole): Dry Hole
Date Well Completed 5/2/84
Application for plugging filed 5/2/84
Plugging commenced 5/2/84
Plugging completed 5/2/84
Reason for abandonment of well or producing formation (CL)
Dry Hole
Was permission obtained from the Conservation Division or it's Agent's before plugging was commenced? Yes

Name of Conservation Agent who supervised plugging of this well Glen Ward
Producing formation ----- Depth to top --- bottom --- T.D. 3,925'
Show depth and thickness of all water, oil and gas formations.

OIL, GAS OR WATER RECORDS — Casing Record

Formation	Content	From	To	Size	Put in	Pulled Out
Dry						

Describe in detail the manner in which the well was plugged, indicating where the mud fluid was placed and the method or methods used in introducing it into the hold. If cement or other plugs were used, state the character of same and depth placed, from ____ feet to ____ feet for each plug set. HOWCO (ticket #759708)

35 sx @ 1100'
35 sx @ 330'
25 sx @ 40' on top of wooden plug and cottonseed hulls
10 sx in rat hole

Total - 105 sx 60/40 poz and 1 sx cottonseed hulls

RECEIVED
STATE CORPORATION COMMISSION
MAY 11 1984
CONSERVATION DIVISION
Wichita, Kansas

(If additional description is necessary, use BACK of this sheet)
Name of Plugging Contractor

STATE OF COLORADO COUNTY OF DENVER, ss.
J. R. Murdoch (employee of ~~owner~~) or (~~xxxxxxx~~ operator) of the above-described well, being first duly sworn on oath, says: That I have knowledge of the facts, statements, and matters herein contained and the log of the above-described well as filed and that the same are true and correct. So help me God.

(Signature) J. R. Murdoch
910 16th St. Denver 80202
(Address)

SUBSCRIBED AND SWORN TO before me this 7th day of May, 1984

Mary Lou Miller
Notary Public.

My Commission expires: 1/8/85