


WELL PLUGGING RECORD

Give All Information Completely
Make Required Affidavit
Mail or Deliver Report to:
Conservation Division
State Corporation Commission
211 No. Broadway
Wichita, Kansas

Ness County. Sec. 26 Twp. 16S Rge. 26W (E) (W)
Location as "NE/CNW&SW&" or footage from lines C SE NE
Lease Owner Kern Drilling Company, Inc.
Lease Name Furman Well No. 1
Office Address 337 Union Center, Wichita, Kansas 67202
Character of Well (completed as Oil, Gas or Dry Hole) Dry Hole
Date well completed April 18 19 67
Application for plugging filed April 18 19 67
Application for plugging approved April 18 19 67
Plugging commenced April 18 19 67
Plugging completed April 18 19 67
Reason for abandonment of well or producing formation Dry Hole

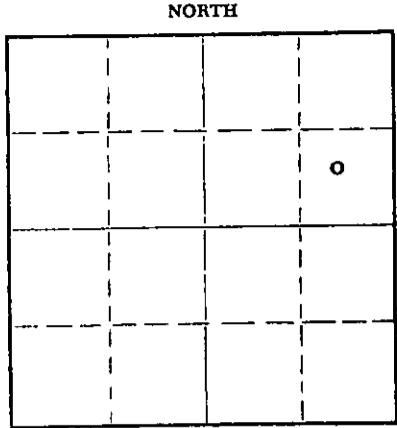

Locate well correctly on above Section Plat

If a producing well is abandoned, date of last production 19
Was permission obtained from the Conservation Division or its agents before plugging was commenced? Yes

Name of Conservation Agent who supervised plugging of this well Leo Massey, Box 582, Hays, Kansas
Producing formation Depth to top Bottom Total Depth of Well 4630 Feet
Show depth and thickness of all water, oil and gas formations.

OIL, GAS OR WATER RECORDS

CASING RECORD

FORMATION	CONTENT	FROM	TO	SIZE	PUT IN	PULLED OUT
		0	275'	8 5/8"	275'	None

Describe in detail the manner in which the well was plugged, indicating where the mud fluid was placed and the method or methods used in introducing it into the hole. If cement or other plugs were used, state the character of same and depth placed, from feet to feet for each plug set.

Set Plug: 1000'/30 sacks cement
250'/20 sacks cement
40'/ 8 sacks cement & 1 sack hulls

RECEIVED
STATE CORPORATION COMMISSION

APR 26 1967
4-26-67

CONSERVATION DIVISION
Wichita, Kansas

(If additional description is necessary, use BACK of this sheet)

Name of Plugging Contractor Hellar Drilling Company, Inc.
Address 1014 Union Center, Wichita, Kansas 67202

STATE OF Kansas, COUNTY OF Sedgwick, ss.
D.L. Hellar, Pres. of Hellar Drilling Co., Inc. (employee of owner) or (owner or operator) of the above-described well, being first duly sworn on oath, says: That I have knowledge of the facts, statements, and matters herein contained and the log of the above-described well as filed and that the same are true and correct. So help me God.

(Signature) *D.L. Hellar* D. L. Hellar, President
1014 Union Center, Wichita, Kansas 67202
(Address)

SUBSCRIBED AND SWORN TO before me this 25th day of April, 19 67

Catherine Darcey
Catherine Darcey - Notary Public.

My commission expires March 25, 1968

15-135-20023-0000

DRILLER'S LOG

COMPANY: Kern Drilling Company, Inc., 337 Union Center, Wichita, Ks
 CONTRACTOR: Hellar Drilling Company, Inc., Wichita, Kansas
 LEASE: #1 Furman
 LOCATION: C SE NE 26-16S-26W, Ness County, Kansas
 COMMENCED: April 6, 1967
 COMPLETED: April 18, 1967
 CASING: Set 8 5/8" surface casing @ 275'/255 sacks cement

0-50	Surface Soil & Sand
50-275	Clay - Shale
2275-650	Blue Shale
650-755	Sand
755-925	Shale & Red Bed
925-975	Sand
975-1386	Shale
1386-1397	Anhydrite
1397-1405	Sand & Shale
1405-1510	Anhydrite
1510-1760	Sand
1760-1997	Shale
1997-2036	Anhydrite
2036-2225	Shale
2225-2515	Salt Section
2515-2705	Salt & Cherty Lime
2705-2870	Lime & Shale
2870-2995	Lime & Cherty Lime
2995-3950	Lime & Shale
3950-4026	Lime & Shale Streaks
4026-4066	L.-K.C. Lime
4066-4170	K. C. Lime
4170-4510	Lime & Shale
4510-4550	Cherty Lime
4550-4583	Lime & Shale
4583-4597	Lime & Shale & Chert
4597-4630	Lime & Dolomite
4630	Rotary Total Depth

RECEIVED
STATE CORPORATION COMMISSION

APR 26 1967

CONSERVATION DIVISION
Wichita, Kansas

D & A

STATE OF KANSAS)
) SS
 COUNTY OF SEDGWICK)

I, D. L. Hellar, do hereby certify that the above and foregoing is a true and correct copy of the log of the #1 Furman, located in C SE NE 26-16S-26W, Ness County, Kansas, as reflected by the files of the Hellar Drilling Company, Inc.

HELLAR DRILLING COMPANY, INC.

By *D. L. Hellar*
 President - D. L. Hellar

Subscribed and sworn to before me, a Notary Public, in and for Sedgwick County, Kansas, this 25th day of April, 1967.

My Commission Expires:
 March 25, 1968.

Catherine Darcey
 Notary Public - Catherine Darcey