


STATE OF KANSAS
STATE CORPORATION COMMISSION

WELL PLUGGING RECORD

Give All Information Completely
Make Required Affidavit
Mail or Deliver Report to
Conservation Division
State Corporation Comm.
245 North Water
Wichita, KS 67202

Ness County. Sec. 29 Twp. 16S Rge. 26 E/W
Location as "NE/CNW 1/4 SW 1/4" or footage from lines

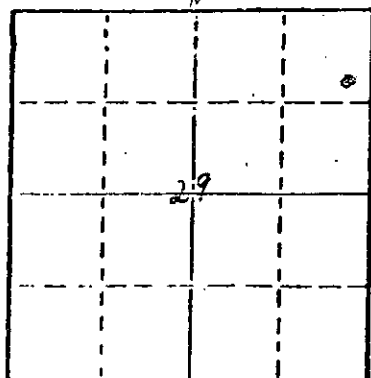

Locate well correctly on above Section Plot

SE NE NE
Lease Owner Blue Goose Drilling Co., Inc. # 5104
Lease Name Shellenberger Well No. 2
Office Address Box 1413 Great Bend, KS 67530
Character of Well (Completed as Oil, Gas or Dry Hole)

Dry Hole
Date Well completed 3-2- 1984
Application for plugging filed 3-2- 1984
Application for plugging approved 3-2- 1984
Plugging commenced 3-2- 1984
Plugging completed 3-2- 1984
Reason for abandonment of well or producing formation

Dry Hole
If a producing well is abandoned, date of last production 19

Was permission obtained from the Conservation Division or its agents before plugging was commenced? YES

Name of Conservation Agent who supervised plugging of this well Richard Lacey
Producing formation _____ Depth to top _____ Bottom _____ Total Depth of Well 4622'
Show depth and thickness of all water, oil and gas formations.

OIL, GAS OR WATER RECORDS

CASING RECORD

FORMATION	CONTENT	FROM	TO	SIZE	PUT IN	PULLED OUT
Surface		0	389'	8 5/8	387'	0

Describe in detail the manner in which the well was plugged, indicating where the mud fluid was placed and the method or methods used in introducing it into the hold. If cement or other plugs were used, state the character of same and depth placed, from _____ feet to _____ feet for each plug set.

4622' T.D. 165 Sacks 60-40 Posmix 2% Gel 3% cc
1st Plug at 2100' with 50 Sacks
2nd Plug at 1020' with 50 Sacks
3rd Plug at 450' with 40 Sacks
Solid Bridge at 40' with 10 Sacks
Rathole 15 Sacks
Plug down at 3:30 P.M. 3-2-84

(If additional description is necessary, use BACK of this sheet)

Name of Plugging Contractor Blue Goose Drilling Co., Inc. # 5104


STATE OF KANSAS COUNTY OF BARTON, ss.
George E. Miller, Jr. (owner or operator)
of the above-described well, being first duly sworn on oath, says: That I have knowledge of the facts, statements, and matters herein contained and the log of the above-described well as filed and that the same are true and correct. So help me God.

(Signature) George E. Miller, Jr.
P.O. Box 1413 Great Bend, KS 67530
(Address)

SUBSCRIBED AND SWORN TO before me this 5th day of March, 19 84

Helen C. Standley
Helen C. Standley Notary Public.

My commission expires 12-8-87

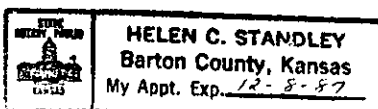

RECEIVED
STATE CORPORATION COMMISSION

MAR 09 1984
3-9-84
CONSERVATION DIVISION
Wichita, Kansas