


15135-22358-0000

STATE OF KANSAS
STATE CORPORATION COMMISSION

WELL PLUGGING RECORD

Give All Information Completely
Make Required Affidavit
Mail or Deliver Report to
Conservation Division
State Corporation Comm.
245 North Water
Wichita, KS 67202

Ness County. Sec. 29 Twp. 16S Rge. 26 E/W
Location as "NE/CNW 1/4 SW 1/4" or footage from lines
SE SE NE
Lease Owner Blue Goose Drilling Company, Inc. # 5104
Lease Name Shellenberger Well No. 1
Office Address PO Box 1413 Great Bend, KS 67530
Character of Well (Completed as Oil, Gas or Dry Hole)
DRY HOLE
Date Well completed 2-18-1983
Application for plugging filed 2-18-1983
Application for plugging approved 2-18-1983
Plugging commenced 2-18-1983
Plugging completed 2-18-1983
Reason for abandonment of well or producing formation
Dry Hole

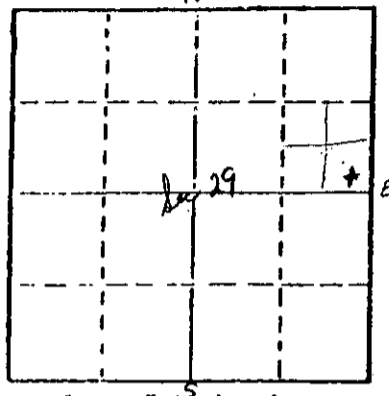

Locate well correctly on above Section Plot

If a producing well is abandoned, date of last production 19
Was permission obtained from the Conservation Division or its agents before plugging was commenced? YES

Name of Conservation Agent who supervised plugging of this well Richard Lacey
Producing formation _____ Depth to top _____ Bottom _____ Total Depth of Well 4645'
Show depth and thickness of all water, oil and gas formations.

OIL, GAS OR WATER RECORDS

CASING RECORD

FORMATION	CONTENT	FROM	TO	SIZE	PUT IN	PULLED OUT
		0	371'	8 5/8	368'	0

Describe in detail the manner in which the well was plugged, indicating where the mud fluid was placed and the method or methods used in introducing it into the hold. If cement or other plugs were used, state the character of same and depth placed, from _____ feet to _____ feet for each plug set.

4645' T.D. 180 Sacks 50-50 Posmix 4% Gel 3% cc
Bottom Plug @ 2130' with 70 Sacks
2nd Plug @ 1080' with 50 Sacks
3rd Plug @ 390' with 40 Sacks
Solid Bridge @ 40' with 10 Sacks
Circulated thru jt. Pipe in Rat Hole with Sacks
Plug down @ 7:30 P.M. on 2-18-83 Sun Cementing Co.

(If additional description is necessary, use BACK of this sheet)

Name of Plugging Contractor Blue Goose Drilling Co., Inc. # 5104 (Expires 6-30-83)

STATE OF KANSAS COUNTY OF BARTON, ss.
George E. Miller, Jr. (employee of owner) or (owner or operator)
of the above-described well, being first duly sworn on oath, says: That I have knowledge of the facts, statements, and matters herein contained and the log of the above-described well as filed and that the same are true and correct. So help me God.

(Signature) George E. Miller, Jr.
P.O. Box 1413 Great Bend, KS 67530
(Address)

SUBSCRIBED AND SWORN TO before me this 22nd day of February, 1983.

Helen C. Standley
Helen C. Standley Notary Public.

My commission expires 12-8-83

STATE NOTARY PUBLIC
HELEN C. STANDLEY
Barton County, Kansas
My Appt. Exp. 12-8-83

RECEIVED
MAR 4 1983
3-4-83
CONSERVATION DIVISION
Wichita, Kansas