

STATE OF KANSAS
STATE CORPORATION COMMISSION

WELL PLUGGING RECORD

16785-21817-6000

Give All Information Completely
Make Required Affidavit
Mail or Deliver Report to
Conservation Division
State Corporation Comm.
245 North Water
Wichita, KS 67202

Ness County. Sec. 29 Twp. 16S Rge. 26W E/W
Location as "NE/CNW/SW" or footage from lines
SE SW NE


Lease Owner S & W Exploration
Lease Name Shellenberger Well No. #1
Office Address 15905 Overbrook, Stanley, Kansas 66224
Character of Well (Completed as Oil, Gas or Dry Hole)
dry hole

Date Well completed June 11, 1980 19
Application for plugging filed June 11, 1980 19
Application for plugging approved June 11, 1980 19
Plugging commenced June 11, 1980 19
Plugging completed June 11, 1980 19
Reason for abandonment of well or producing formation
dry hole

If a producing well is abandoned, date of last production 19

Was permission obtained from the Conservation Division or its agents before plugging was commenced? yes

Name of Conservation Agent who supervised plugging of this well Marion Schmidt
Producing formation Depth to top Bottom Total Depth of Well 4616'
Show depth and thickness of all water, oil and gas formations.

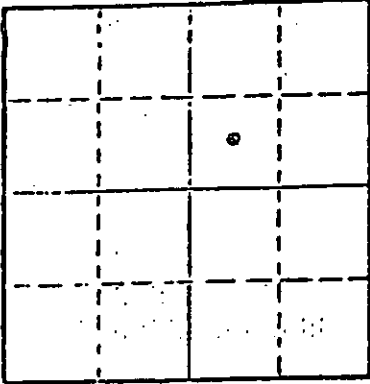

Locate well correctly on above Section Plot

OIL, GAS OR WATER RECORDS

CASING RECORD

FORMATION	CONTENT	FROM	TO	SIZE	PUT IN	PULLED OUT

Describe in detail the manner in which the well was plugged, indicating where the mud fluid was placed and the method or methods used in introducing it into the hold. If cement or other plugs were used, state the character of same and depth placed, from feet to feet for each plug set.

Hole plugged with 50-50 pozmix, 6% gel, as follows:
60 sacks at 1220', 20 dacks at 530', hulls and
10 sacks at 40', 3 sacks in rathole, 2 sacks in
mousehole.

RECEIVED
STATE CORPORATION COMMISSION
JUN 25 1980
6-25-80
CONSERVATION DIVISION
Wichita, Kansas

(If additional description is necessary, use BACK of this sheet)

Name of Plugging Contractor Strata Drilling Company

STATE OF KANSAS COUNTY OF BARTON, ss.
Charles W. Steincamp (employee of owner) or (owner or operator)
of the above-described well, being first duly sworn on oath, says: That I have knowledge of the facts, statements, and matters herein contained and the log of the above-described well as filed and that the same are true and correct. So help me God.

(Signature) Charles W. Steincamp
P. O. Box 355, Great Bend, Kansas 67530
(Address)

SUBSCRIBED AND SWORN TO before me this 20th day of June, 1980

Loneita Barry
Loneita Barry Notary Public.

My commission expires 3-28-84



15-135-21817-0000

D R I L L E R S L O G

#1 Shellenberger

CASING RECORD:
8 jts. new 20#
8-5/8" surface
casing

COMPANY:

DESCRIPTION: ~~SE~~SW NE
Section 29-16S-26W
Ness County, Kansas

CONTRACTOR: Strata Drilling Company

COMMENCED: June 4, 1980

TOTAL ROTARY
DEPTH: 4616'

COMPLETED: June 11, 1980

D & A

<u>FORMATION</u>	<u>FROM</u>	<u>TO</u>	<u>REMARKS</u>
Surface soil, shale	0	345	Ran 332' new 20# 8-5/9" surface casing; set and cemented at 337' with 200 sx. common cement, 2% gel, 3% C.C. Cement circulated. Plug down at 10:00 p.m., June 4, 1980.
Shale, sand, shale	345	2090	
Anhydrite	2090	2122	
Shale	2122	2630	
Lime and shale	2630	4270	Ran 2 drill stem tests Hole plugged with 50-50 pozmix, 6% gel, as follows: 60 sacks @ 1220', 30 sacks @ 530', hulls and 10 sacks @ 40', 3 sacks in rathole, 2 sacks in mousehole. Plugging completed at 10:30 a.m., June 11, 1980.
Lime	4270	4390	
Lime and shale	4390	4470	
Lime	4470	4560	
Lime and shale	4560	4616	

RECEIVED
STATE CORPORATION COMMISSION

JUN 25 1980

CONSERVATION DIVISION
Wichita, Kansas

STATE OF KANSAS)
)ss
COUNTY OF BARTON)

I certify that this is a true and correct copy of the above log to the best of my knowledge.

STRATA DRILLING COMPANY

Charles W. Steincamp
Charles W. Steincamp

Sworn to and subscribed before me this 20th day of June, 1980.

My appointment expires 3-28-84.

Loneita Barry
Loneita Barry, Notary Public

