

15-185-21525-0000

STATE OF KANSAS
STATE CORPORATION COMMISSION

WELL PLUGGING RECORD

Give All Information Completely
Make Required Affidavit
Mail or Deliver Report to
Conservation Division
State Corporation Comm.
245 North Water
Wichita, KS 67202

Ness County, Sec. 29 Twp. 16S Rge. 26W E/W
Location as "NE/CNW 1/4 SW 1/4" or footage from lines
NW NE SW


Lease Owner Darrah and Palomino
Lease Name Bondurant C Well No. #1
Office Address Suite 1010 Century Plaza Bldg., Wichita, Kansas
Character of Well (Completed as Oil, Gas or Dry Hole) dry hole

Date Well completed October 24, 1978 19
Application for plugging filed October 24, 1978 19
Application for plugging approved October 24, 1978 19
Plugging commenced October 24, 1978 19
Plugging completed October 24, 1978 19
Reason for abandonment of well or producing formation dry hole

If a producing well is abandoned, date of last production 19

Was permission obtained from the Conservation Division or its agents before plugging was commenced? yes

Name of Conservation Agent who supervised plugging of this well Leo Massey
Producing formation Depth to top Bottom Total Depth of Well 4586'
Show depth and thickness of all water, oil and gas formations.

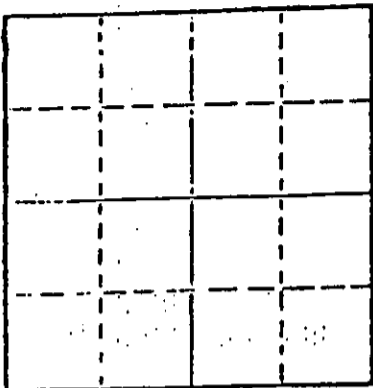

Locate well correctly on above Section Plat

OIL, GAS OR WATER RECORDS

CASING RECORD

FORMATION	CONTENT	FROM	TO	SIZE	PUT IN	PULLED OUT

Describe in detail the manner in which the well was plugged, indicating where the mud fluid was placed and the method or methods used in introducing it into the hold. If cement or other plugs were used, state the character of same and depth placed, from feet to feet for each plug set. Hole plugged with 50-50 pozmix, 6% gel, as follows: 70 sacks @ 720', 20 sacks @ 300', hulls and 10 sacks @ 40'. Plugging completed at 3:30 p.m., October 24, 1978.

RECEIVED
STATE CORPORATION COMMISSION

NOV - 9 1978

11-9-78

CONSERVATION DIVISION
WICHITA, KANSAS

(If additional description is necessary, use BACK of this sheet)

Name of Plugging Contractor Strata Drilling Company

STATE OF KANSAS COUNTY OF BARTON, ss.
Kenneth J. Link (employee of owner) or (owner or operator)
of the above-described well, being first duly sworn on oath, says: That I have knowledge of the facts, statements, and matters herein contained and the log of the above-described well as filed and that the same are true and correct. So help me God.

(Signature) Kenneth J. Link President
P. O. Box 355, Great Bend, Kansas 67530
(Address)

SUBSCRIBED AND SWORN TO before me this 2nd day of November, 1978

Loneita Barry
Loneita Barry Notary Public.

My commission expires 3-28-80



D R I L L E R S L O G

#1 Bondurant: "C"

CASING RECORD: 8 jts. new 20# 8-5/8" surface casing.	COMPANY: Darrah and Palomino	DESCRIPTION: NW NE SW Section 29-16S-26W Ness County, Kansas
TOTAL ROTARY DEPTH: 4586'	CONTRACTOR: Strata Drilling Company	ELEVATION: 2651' KB
	COMMENCED: October 18, 1978	
	COMPLETED: October 24, 1978	

D : & A

<u>FORMATION</u>	<u>FROM</u>	<u>TO</u>	<u>REMARKS</u>
Shale	0	335	Ran 323' new 20# 8-5/8" surface casing, set and cemented at #28' with 200 sacks common cement, 2% gel, 3% C.C. Cement circulated. Plug down at 9:20 p.m., October 18, 1978.
Shale, sand, shale	335	2087	
Anhydrite	2087	2123	
Shale	2123	2655	
Lime and shale	2655	4560	
Lime	4560	4586	Ran one drill stem test.
			Hole plugged with 50-50 pozmix, 6% gel, as follows: 70 sacks at 720', 20 sacks at 300', hulls and 10 sacks at 40'. Plugging completed at 3:30 p.m., October 24, 1978.

STATE OF KANSAS)
)ss
COUNTY OF BARTON)

I certify that this is a true and correct copy of the above log to the best of my knowledge.

STRATA DRILLING COMPANY

Kenneth J. Link

Kenneth J. Link, President

Sworn to and subscribed before me this 2nd day of November, 1978.

My appointment expires 3-28-80.



Loneita Barry

Loneita Barry, Notary Public

RECEIVED
STATE CORPORATION COMMISSION
NOV - 9 1978
CONSERVATION DIVISION
Wichita, Kansas