


STATE OF KANSAS
STATE CORPORATION COMMISSION

15/35.71503.0000

WELL PLUGGING RECORD

Give All Information Completely
Make Required Affidavit
Mail or Deliver Report to
Conservation Division
State Corporation Comm.
245 North Water
Wichita, KS 67202

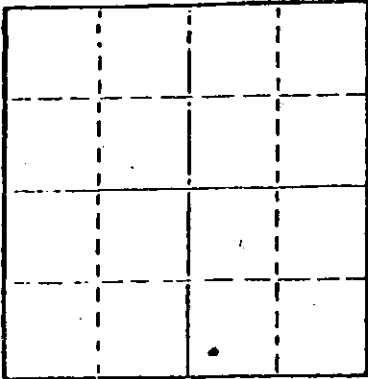

Locate well correctly on above
Section Plot

Ness County. Sec. 29 Twp. 16 Rge. 26 E/W
Location as "NE/CNW/SW" or footage from lines
SW SW SE
Lease Owner Palomino Petroleum
Lease Name Shellenberger Well No. 1
Office Address 500 Insurance Bldg., Wichita, Kansas
Character of Well (Completed as Oil, Gas or Dry Hole) 67202
oil
Date Well completed 19
Application for plugging filed Dec. 18 1978
Application for plugging approved 19
Plugging commenced Dec. 19 1978
Plugging completed Jan. 4 1979
Reason for abandonment of well or producing formation depleted

If a producing well is abandoned, date of last production 19

Was permission obtained from the Conservation Division or its agents before plugging was commenced? yes

Name of Conservation Agent who supervised plugging of this well Leo Massey
Producing formation Depth to top Bottom Total Depth of Well 4588'
Show depth and thickness of all water, oil and gas formations.

OIL, GAS OR WATER RECORDS

CASING RECORD

FORMATION	CONTENT	FROM	TO	SIZE	PUT IN	PULLED OUT
			325'	8 5/8"	325'	none
			4580'	4 1/2"	4580'	3013.57

Describe in detail the manner in which the well was plugged, indicating where the mud fluid was placed and the method or methods used in introducing it into the hold. If cement or other plugs were used, state the character of same and depth placed, from feet to feet for each plug set.

Sanded back to 4150' and dumped 3 sacks of cement.

Allied Cementing Co., Inc. plugged well pumping in 28 sacks of gel and 140 sacks of cement.

RECEIVED
STATE CORPORATION COMMISSION
1-11-79
JAN 11 1979


(If additional description is necessary, use BACK of this sheet)
Name of Plugging Contractor PIPE PULLERS, INC. CONSERVATION DIVISION
Box 128, Ellinwood, Kansas 67526 Wichita, Kansas

STATE OF KANSAS COUNTY OF BARTON, ss.
Evelyn Roth (employee of owner) or (owner or operator)
of the above-described well, being first duly sworn on oath, says: That I have knowledge of the facts, statements, and matters herein contained and the log of the above-described well as filed and that the same are true and correct. So help me God.

(Signature) Evelyn Roth
Ellinwood, Kansas
(Address)

SUBSCRIBED AND SWORN TO before me this 9th day of January, 1979

My commission expires

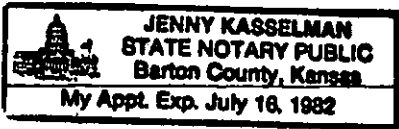

Jenny Kasselmann
Notary Public.

