


STATE OF KANSAS
STATE CORPORATION COMMISSION

WELL PLUGGING RECORD

Give All Information Completely
Make Required Affidavit
Mail or Deliver Report to
Conservation Division
State Corporation Comm.
245 North Water
Wichita, KS 67202

Ness County. Sec. 27 Twp. 16S Rge. 26 E/W
Location as "NE/CNW $\frac{1}{4}$ SW $\frac{1}{4}$ " or footage from lines
C SW/4
Lease Owner Publishers Petroleum
Lease Name Horchem Well No. 1
Office Address P.O. Box 25125, Okla. City, Okla. 73125
Character of Well (Completed as Oil, Gas or Dry Hole) dry hole

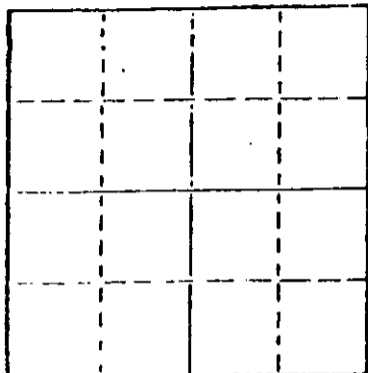

Locate well correctly on above
Section Plot

Date Well completed 8-17-1980
Application for plugging filed 8-17-1980
Application for plugging approved 8-17-1980
Plugging commenced 8-17-1980
Plugging completed 8-17-1980
Reason for abandonment of well or producing formation
no commercial quantities of oil or gas encountered
If a producing well is abandoned, date of last production -- 19

Was permission obtained from the Conservation Division or
its agents before plugging was commenced? yes

Name of Conservation Agent who supervised plugging of this well Marion Schmidt
Producing formation Depth to top Bottom Total Depth of Well 4605
Show depth and thickness of all water, oil and gas formations.

OIL, GAS OR WATER RECORDS

CASING RECORD

FORMATION	CONTENT	FROM	TO	SIZE	PUT IN	PULLED OUT
surface hole	shale	surf	317'	8-5/8	309	none

Describe in detail the manner in which the well was plugged, indicating where the mud fluid was placed and the method or methods used in introducing it into the hold. If cement or other plugs were used, state the character of same and depth placed, from feet to feet for each plug set.

Fluid to 1220', plug, 70 sx
Fluid to 300', plug, 25 sx
Fluid to 40', plug, 10 sx
Rat hole 5 sx

RECEIVED
STATE CORPORATION COMMISSION

AUG 25 1980
8-25-80
CONSERVATION DIVISION
Wichita, Kansas

(If additional description is necessary, use BACK of this sheet)

Name of Plugging Contractor D N B DRILLING, INC.
515 R. H. Garvey Building
Wichita, Kansas 67202

STATE OF Kansas COUNTY OF Sedgwick, ss.
Ella Priess (employee of owner) or (owner or operator)
of the above-described well, being first duly sworn on oath, says: That I have knowledge of the facts, statements, and matters herein contained and the log of the above-described well as filed and that the same are true and correct. So help me God.

(Signature)

Ella Priess

515 R.H. Garvey Bldg. Wichita, Ks. 67202
(Address)

SUBSCRIBED AND SWORN TO before me this 18th day of August, 1980

Dorothy L. Schmidt
Dorothy L. Schmidt Notary Public.

My commission expires April 30, 1983

DOROTHY L. SCHMIDT
STATE NOTARY PUBLIC
Sedgwick County, Kansas
My Appt. Exp. April 30, 1983

DRILLER'S LOG

15-135-21861-0000

PUBLISHERS PETROLEUM
No. 1 Horchem
C SW SW Sec 27-16S-26W
Ness Co., Ks.

Commenced: 8-9-80
Completed: 8-17-80

Surface Casing: 309' of 8-5/8" cemented
w/200 sx common, 2% gel, 3% cc

FORMATION

DEPTH

Surface Hole	0 - 317
Shale & Shells	317 - 830
Shale & Sand	830 - 1477
Shale, Sand & Red Bed	1477 - 1865
Shale & Lime	1865 - 2475
Lime & Shale	2475 - 2755
Shale & Lime	2755 - 3170
Lime & Shale	3170 - 4215
Lime	4215 - 4605 RTD

I do hereby certify that the foregoing statements are true and correct to the best of my knowledge and belief.

D. N. B. DRILLING, INC.

Ella Priess

Ella Priess

STATE OF KANSAS: ss:

Subscribed and sworn to before me this 19th day of August, 1980.

Dorothy L. Schmidt

Dorothy L. Schmidt, Notary Public

DOROTHY L. SCHMIDT
STATE NOTARY PUBLIC
Sedgwick County, Kansas
My Appt. Exp. April 30, 1983

RECEIVED
STATE CORPORATION COMMISSION

AUG 25 1980

CONSERVATION DIVISION
Wichita, Kansas.