

STATE CORPORATION COMMISSION OF KANSAS
OIL & GAS CONSERVATION DIVISION

WELL COMPLETION OR RECOMPLETION FORM
ACO-1 WELL HISTORY

DESCRIPTION OF WELL AND LEASE

Operator: license # 5026
name Euwer Petroleum Co. #2
address Suite 816, KSB Bldg.,
125 N. Market
City/State/Zip Wichita, KS 67202

Operator Contact Person Robert M. Euwer
Phone (316) 267-3361

Contractor: license # 5659
name Bergman Drilling, Inc.

Wellsite Geologist Charles I. Slagle
Phone 267-7082

PURCHASER

Designate Type of Completion

New Well Re-Entry Workover

- Oil SWD Temp Abd
- Gas Inj Delayed Comp.
- Dry Other (Core, Water Supply etc.)

If OWWO: old well info as follows:

Operator
Well Name
Comp. Date Old Total Depth

WELL HISTORY

Drilling Method: Mud Rotary Air Rotary Cable
9-4-84 9-15-84 9-15-84
Spud Date Date Reached TD Completion Date

4800.33
Total Depth PBD

Amount of Surface Pipe Set and Cemented at 260.1 KB feet

Multiple Stage Cementing Collar Used? Yes No

If Yes, Show Depth Set feet

If alternate 2 completion, cement circulated
from feet depth to w/ SX cmt

API NO. 15 - 007-21,026-00-00

County Harper

NW SE NW Sec 17 Twp 32 Rge 7 East West

3630 Ft North from Southeast Corner of Section
3630 Ft West from Southeast Corner of Section
(Note: locate well in section plat below)


Lease Name Fleming Well# 1

Field Name Wildcat

Producing Formation

Elevation: Ground 1424 KB 1429

Section Plat

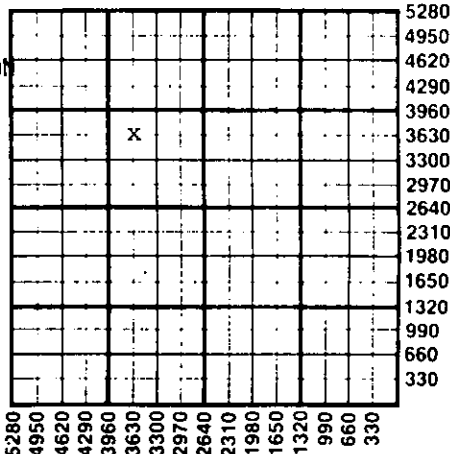

RECEIVED
STATE CORPORATION COMMISSION
10-10-1984
OCT 10 1984
CONSERVATION DIVISION
Wichita, Kansas

WATER SUPPLY INFORMATION

Source of Water: Temporary Water Well

Division of Water Resources Permit # 4131

Groundwater 3630 Ft North From Southeast Corner and
(Well) 3630 Ft. West From Southeast Corner of
Sec 17 Twp 32 Rge 7 East West

Surface Water Ft North From Southeast Corner and
(Stream, Pond etc.) Ft West From Southeast Corner
Sec Twp Rge East West

Other (explain)
(purchased from city, R.W.D.#)

Disposition of Produced Water: Disposal Repressuring

Docket #

INSTRUCTIONS: This form shall be completed in duplicate and filed with the Kansas Corporation Commission, 200 Colorado Derby Building, Wichita, Kansas 67202, within 90 days after completion or recompletion of any well. Rules 82-3-130 and 82-3-107 apply.

Information on side two of this form will be held confidential for a period of 12 months if requested in writing and submitted with the form. See rule 82-3-107 for confidentiality in excess of 12 months.

One copy of all wireline logs and drillers time log shall be attached with this form. Submit CP-4 form with all plugged wells. Submit CP-111 form with all temporarily abandoned wells.

All requirements of the statutes, rules, and regulations promulgated to regulate the oil and gas industry have been fully complied with and the statements herein are complete and correct to the best of my knowledge.

Signature Robert M. Euwer
Title Managing Partner Date 10-3-84

Subscribed and sworn to before me this 3rd day of October 19 84

Notary Public Carolyn Shoemaker
Date Commission Expires 6-29-86

K.C.C. OFFICE USE ONLY
F Letter of Confidentiality Attached
C Wireline Log Received
C Drillers Timelog Received
Distribution
 KCC SWD/Rep NGPA
 KGS Plug Other (Specify)

Operator Name Euwer Petroleum Co. #2 Lease Name Fleming Well# 1 SEC. 17 TWP. 32 RGE. 7 East West

WELL LOG

INSTRUCTIONS: Show important tops and base of formations penetrated. Detail all cores. Report all drill stem tests giving interval tested, time tool open and closed, flowing and shut-in pressures, whether shut-in pressure reached static level, hydrostatic pressures, bottom hole temperature, fluid recovery, and flow rates if gas to surface during test. Attach extra sheet if more space is needed. Attach copy of log.

Drill Stem Tests Taken Yes No
 Samples Sent to Geological Survey Yes No
 Cores Taken Yes No

Formation Description
 Log Sample

DST #1 3979 - 4000'
 Open 30 SI 60 Open 60 SI 90
 Rec. 90' of oil-cut muddy water; 35% Mud, 2% Oil, 63% Water.
 IFP 62# - 52# FFP 72# - 72#
 IBHP 1606#/60 FBHP 1485#/90
 BHT 126°

| Name | Top | Bottom |
|------------------|------|---------|
| Heebner | 3287 | (-1858) |
| Douglas | 3411 | (-1982) |
| Kansas City | 3846 | (-2417) |
| Black Shale | 2980 | (-2551) |
| B/Kansas City | 4064 | (-2635) |
| Mississippian | 4413 | (-2984) |
| Kinderhook | 4649 | (-3220) |
| Viola | 4746 | (-3317) |
| Simpson Dolomite | 4784 | (-3355) |
| TD | 4800 | (-3371) |

DST #2 4416 - 4430
 Open 30 SI 60 Open 90 SI 90
 350' Gas in pipe, 70' of mud w/slightly gassy oil.
 IFP 52# - 52# FFP 52# - 41#
 IBHP 675#/60 FBHP 883#/90
 BHT 134°

DST #3 4430 - 4444'
 Open 30 SI 60 Open 90 SI 90
 Strong blow throughout. Gas to surface on 2nd open, 14,100 CFGPD throughout. Recovered total fluid of 816':
 80' Oil & Gas cut SWM
 60' " " " " MW
 60' Gas & Oil cut MW
 120' Oil cut W
 496' SW
 IFP 104# - 176# FFP 260# - 416#
 IBHP 1663#/60 FBHP 1663#/90
 BHT 142°

CASING RECORD new used

Report all strings set - conductor, surface, intermediate, production, etc.

| Purpose of string | size hole drilled | size casing set (in O.D.) | weight lbs/ft. | setting depth | type of cement | # sacks used | type and percent additives |
|-------------------|-------------------|---------------------------|----------------|---------------|----------------|--------------|----------------------------|
| | 12 1/2" | 8 5/8" | 20 lb. 253' | 260' KB | 60/40 Poz | 150 | 3% CC, 2% Gel |

PERFORATION RECORD

Acid, Fracture, Shot, Cement Squeeze Record

| shots per foot | specify footage of each interval perforated | (amount and kind of material used) | Depth |
|----------------|---|------------------------------------|-------|
| | | | |

TUBING RECORD

size set at packer at Liner Run Yes No

Date of First Production Producing method flowing pumping gas lift Other (explain)

| Estimated Production Per 24 Hours | Oil Bbls | Gas MCF | Water Bbls | Gas-Oil Ratio CFPB | Gravity |
|-----------------------------------|----------|---------|------------|--------------------|---------|
| | | | | | |

METHOD OF COMPLETION

PRODUCTION INTERVAL

Disposition of gas: vented
 sold
 used on lease

open hole perforation
 other (specify)

Dually Completed.
 Commingled