

STATE OF KANSAS
STATE CORPORATION COMMISSION

WELL PLUGGING RECORD

Give All Information Completely
Make Required Affidavit
Mail or Deliver Report to
Conservation Division
State Corporation Comm.
245 North Water
Wichita, KS 67202

Harper County, Sec. 15 Twp. 32S Rge. 7-W E/W
Location as "NE/CNW/SW" or footage from lines

660 FSL 1320 FWL

Lease Owner Texas Oil & Gas Corp.

Lease Name Schiefelbine Well No. 1

Office Address 200 W. Douglas, Suite 300, Wichita 67202

Character of Well (Completed as Oil, Gas or Dry Hole)
Dry Hole

Date Well completed 8-30 1977

Application for plugging filed 9-2- 1977

Application for plugging approved 19

Plugging commenced 9-6- 1977

Plugging completed 9-9- 1977

Reason for abandonment of well or producing formation


If a producing well is abandoned, date of last production
19

Was permission obtained from the Conservation Division or
its agents before plugging was commenced? yes

Name of Conservation Agent who supervised plugging of this well Bill Owens

Producing formation _____ Depth to top _____ Bottom _____ Total Depth of Well 4399

Show depth and thickness of all water, oil and gas formations.

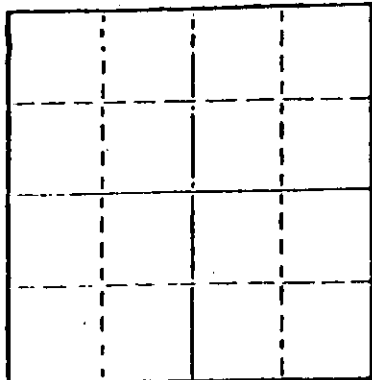

Locate well correctly on above
Section Plot

OIL, GAS OR WATER RECORDS

CASING RECORD

FORMATION	CONTENT	FROM	TO	SIZE	PUT IN	PULLED OUT
				8 5/8	280	None
				4 1/2	4385	3906

Describe in detail the manner in which the well was plugged, indicating where the mud fluid was placed and the method or methods used in introducing it into the hold. If cement or other plugs were used, state the character of same and depth placed, from _____ feet to _____ feet for each plug set.

Sand from 4399 to 4375'

4 sacks cement dumped with dump bailer from 4375 to 4345'

Ripped at 3906'

Wooden bridge at 300'

Rock from 300 to 290'

6 yards of ready mix

RECEIVED
STATE CORPORATION COMMISSION

OCT 27 1977

10-27-1977

CONSERVATION DIVISION
Wichita, Kansas

(If additional description is necessary, use BACK of this sheet)

Name of Plugging Contractor Clarke Corporation

STATE OF KANSAS COUNTY OF SEDGWICK, ss.

TEXAS OIL & GAS CORP. (employee of owner) or (owner or operator)

of the above-described well, being first duly sworn on oath, says: That I have knowledge of the facts, statements, and matters herein contained and the log of the above-described well as filed and that the same are true and correct. So help me God.


(Signature)

TEXAS OIL & GAS CORP.

By: Harold A. Brown
200 W. Douglas, Suite 300, Wichita, KS 67202

(Address)

SUBSCRIBED AND SWORN TO before me this 26th day of October, 1977.

 

Yolanda Eurbank
Notary Public.

My commission expires February 3, 1980

DRILLER'S LOG

15-077-20401-00-00 Dup

COMPANY: Texas Oil & Gas Corporation

SEC. 15 T. 32S R. 7W

WELL NAME: Schiefelbine #1

LOC. 660' FSL & 1320' FWL

COUNTY: Harper

RIG NO. #3

TOTAL DEPTH 4399'

ELEVATION

COMMENCED: 2-1-77

COMPLETED: 2-11-77

CONTRACTOR: Rains & Williamson Oil Co., Inc.

CASING RECORD:

SURFACE: 8 5/8" @ 281' w/150 sx. Lite, 3% gel, 2% cc. and 100 sx. 50/50 poz. 3% gel, 2% cc.

PRODUCTION: 4 1/2" @ 4385' w/125 sx. 50/50 poz.

LOG

(Figures Indicate Bottom of Formations)

Sand	15
Redbed & Shale	38
Shale	1440
Shale & Lime	2690
Lime & Shale	2853
Shale & Lime	3165
Lime & Shale	4110
Shale & Lime	4234
Lime & Shale	4399
<u>ROTARY TOTAL DEPTH</u>	<u>4399</u>

RECEIVED
STATE CORPORATION COMMISSION
OCT 27 1977
10-27-1977
CONSERVATION DIVISION
Wichita, Kansas

STATE OF Kansas)
COUNTY OF Sedgwick) SS:

I, Wilson Rains, President of Rains & Williamson Oil Co., Inc.
upon oath state that the above and foregoing is a true and correct copy of the log of the
Schiefelbine #1 well.

Wilson Rains
Wilson Rains

Subscribed and sworn to before me this 14 day of February, 1977.

My Appointment Expires:
10-4-79

Juanita M. Green
Juanita M. Green

