

CARD MUST BE TYPED



State of Kansas
NOTICE OF INTENTION TO DRILL
(see rules on reverse side)

CARD MUST BE SIGNED

Starting Date: 7-20-85
month day year

OPERATOR: License # 5004
Name Vincent Oil Corporation
Address 125 N. Market, Suite 1110
City/State/Zip Wichita, Kansas 67202
Contact Person Donna Manda
Phone 316-262-3573

CONTRACTOR: License # 5149
Name Wheatstate Oilfield Services, Inc.
City/State Pratt, Kansas 67214

Well Drilled For: Well Class: Type Equipment:
 Oil Swd Infield Mud Rotary
 Gas Inj Pool Ext. Air Rotary
 OWWO Expl Wildcat Cable

If OWWO: old well info as follows:

Operator Wells Energy Company
Well Name #1 Schreiner
Comp Date 12-9-79 Old Total Depth 4444
Projected Total Depth 4810 feet
Projected Formation at TD Simpson
Expected Producing Formations

API Number 15-007-20,840-00-01
NE/4 SE/4 Sec 11 Twp 32 S, Rge 10
(location) East West

1980 Ft North from Southeast Corner of Section
660 Ft West from Southeast Corner of Section
(Note: Locate well on Section Plat on reverse side)

Nearest lease or unit boundary line 660 feet.
County Barber
Lease Name Schreiner "B" Well# #1
Domestic well within 330 feet: yes no
Municipal well within one mile: yes no

Depth to Bottom of fresh water 80 feet
Lowest usable water formation
Depth to Bottom of usable water 200 feet
Surface pipe by Alternate: 1 2
Surface pipe set 244 feet
Conductor pipe if any required N/A feet
Ground surface elevation 7504 feet MSL
This Authorization Expires 1-16-86
Approved By 7-16-85

I certify that we will comply with K.S.A. 55-101, et seq., plus eventually plugging hole to K.C.C. specifications.

Date 7-16-85 Signature of Operator or Agent Richard A. Hiebsch Title Vice President

Must be filed with the K.C.C. five (5) days prior to commencing well
This card void if drilling not started within six (6) months of date received by K.C.C.

RECEIVED
STATE CORPORATION COMMISSION

07-16-1985

Important procedures to follow:

A Regular Section of Land
1 Mile = 5,280 Ft.

1111 1 6 1985

Notify District office before setting surface casing.

2. Set surface casing by circulating cement to the top.

CONSERVATION DIVISION
Wichita, Kansas

3. File completion forms ACO-1 with K.C.C. within 90 days of well completion, following instructions on ACO-1, side 1, and including copies of wireline logs.

4. Notify District office 48 hours prior to old well workover or re-entry.


5. Prior to plugging, prepare a plugging plan, then obtain agreement from the appropriate district office for an approved plugging plan.

6. Submit plugging report (CP-4) to K.C.C. after plugging is completed.

7. Obtain an approved injection docket number before disposing of salt water.

8. Notify K.C.C. within 10 days when injection commences or terminates.

9. If an alternate 2 completion, cement in the production pipe from below any usable water to surface within 120 days of spud date.

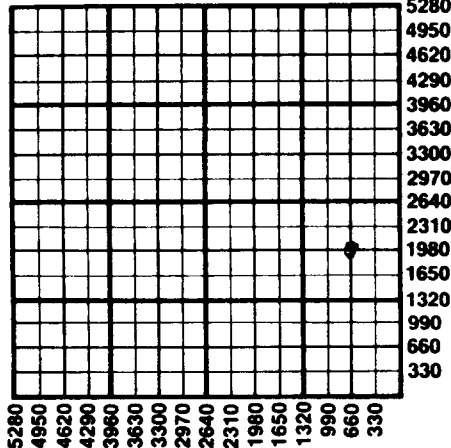

State Corporation Commission of Kansas
Conservation Division
200 Colorado Derby Building
Wichita, Kansas 67202
(316) 263-3238