

CARD MUST BE TYPED

State of Kansas
NOTICE OF INTENTION TO DRILL
(see rules on reverse side)

CARD MUST BE SIGNED

Starting Date: September 11, 1985
month day year

OPERATOR: License # 5050
Name Hummon Corporation
Address 400 One Main Place
City/State/Zip Wichita, Kansas 67202
Contact Person Wilber Berg
Phone (316) 263-8521

CONTRACTOR: License # 5148
Name Big-H Drilling, Inc.
City/State Wichita, Kansas 67202

Well Drilled For: Well Class: Type Equipment:
 Oil Swd Infield Mud Rotary
 Gas Inj Pool Ext. Air Rotary
 OWWO Expl Wildcat Cable

If OWWO: old well info as follows:

Operator
Well Name
Comp Date Old Total Depth
Projected Total Depth 3750 feet
Projected Formation at TD Douglas Limestone
Expected Producing Formations Douglas Limestone

API Number 15- 007-22,080-00-00
150' NW/C
NW NW Sec 8 Twp 32 S, Rge 10 East
(location) West

4726 Ft North from Southeast Corner of Section
4726 Ft West from Southeast Corner of Section
(Note: Locate well on Section Plat on reverse side)

Nearest lease or unit boundary line 554 feet.
County Barber
Lease Name Edna Well# 1

Domestic well within 330 feet: yes no
Municipal well within one mile: yes no

Depth to Bottom of fresh water 150 feet
Lowest usable water formation Salt Plain Salt
Depth to Bottom of usable water 200 feet
Surface pipe by Alternate: 1 2
Surface pipe to be set 200 feet
Conductor pipe if any required None feet
Ground surface elevation feet MSL
This Authorization Expires 3-8-86

Approved By 9-9-85

I certify that we will comply with K.S.A. 55-101, et seq., plus eventually plugging hole to K.C.C. specifications.

Date 8-20-85 Signature of Operator or Agent

Kenneth S. White
Kenneth S. White

Agent

RCM FOR KONE

Must be filed with the K.C.C. five (5) days prior to commencing well
This card void if not started within six (6) months of date received by K.C.C.

RECEIVED
STATE CORPORATION COMMISSION

SEP 3 1985

09-09-1985

Important procedures to follow:

A Regular Section of Land CONSERVATION DIVISION
1 Mile = 5,280 Ft. Wichita, Kansas

1. Notify District office before setting surface casing.

2. Set surface casing by circulating cement to the top.

3. File completion forms ACO-1 with K.C.C. within 90 days of well completion, following instructions on ACO-1, side 1, and including copies of wireline logs.

4. Notify District office 48 hours prior to old well workover or re-entry.


5. Prior to plugging, prepare a plugging plan, then obtain agreement from the appropriate district office for an approved plugging plan.

6. Submit plugging report (CP-4) to K.C.C. after plugging is completed.

7. Obtain an approved injection docket number before disposing of salt water.

8. Notify K.C.C. within 10 days when injection commences or terminates.

9. If an alternate 2 completion, cement in the production pipe from below any usable water to surface within 120 days of spud date.

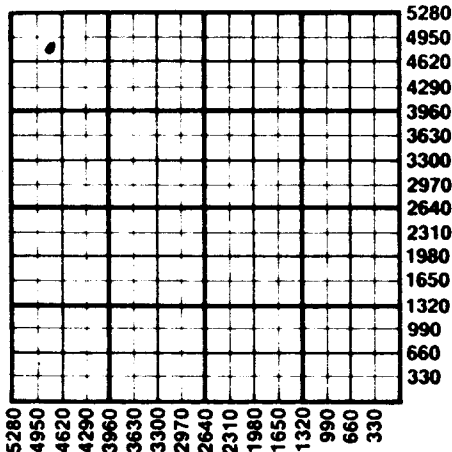

State Corporation Commission of Kansas
Conservation Division
200 Colorado Derby Building
Wichita, Kansas 67202
(316) 263-3238