

CARD MUST BE TYPED

State of Kansas

CARD MUST BE SIGNED

NOTICE OF INTENTION TO DRILL

(see rules on reverse side)

Expected Spud Date..... 11 / 7 / 87
month day year

API Number 15— 135-23,185-0000

OPERATOR: License # 5123

SE. SW. SW. Sec. 12. Twp. 18 S, Rg. 21 East X West

Name Pickrell Drilling Company, Inc.

330' Ft. from South Line of Section

Address 110 North Market, Suite 205

4290' Ft. from East Line of Section

City/State/Zip Wichita, Kansas 67202

(Note: Locate well on Section Plat on reverse side)

Contact Person Jay C. McNeil

Nearest lease or unit boundary line 330 feet

Phone (316) 262-8427

County Ness

CONTRACTOR: License # 5123

Lease Name Young Well # 1-LL

Name Pickrell Drilling Company, Inc.

Ground surface elevation feet MSL

City/State Wichita, Kansas 67202

Domestic well within 330 feet: yes X no

Well Drilled For: Well Class: Type Equipment:

Municipal well within one mile: yes X no

XX Oil Storage Infield XX Mud Rotary

Depth to bottom of fresh water 160

 Gas Inj Pool Ext. Air Rotary

Depth to bottom of usable water 375

 OWWO Expl XX Wildcat Cable

Surface pipe by Alternate: 1 2 X

If OWWO: old well info as follows:

Surface pipe planned to be set 300+'

Operator

Conductor pipe required

Well Name

Projected Total Depth 4200 feet

Comp Date Old Total Depth

Formation Miss

I certify that well will comply with K.S.A. 55-101, et seq., plus eventually plugging hole to KCC specifications.

Date 11-2-87 Signature of Operator or Agent Jay C. McNeil

Title Chief Geologist

For KCC Use:

Conductor Pipe Required feet; Minimum Surface Pipe Required 200 feet per Alt. X (2)

This Authorization Expires 5-2-88 Approved By R.H. 11-2-87


Effective
11-7-87

Must be filed with the K.C.C. five (5) days prior to commencing well
This card void if drilling not started within six (6) months of date received by K.C.C.

Important procedures to follow:

1. Notify District office before setting surface casing.
2. Set surface casing by circulating cement to the top.
3. File completion forms ACO-1 with K.C.C. within 120 days of well spud date, following instructions on ACO-1, side 1, and including copies of wireline logs.
4. Notify District office 48 hours prior to old well workover or re-entry.
5. Prior to filing Intent, prepare a proposed plugging plan in case well is D & A, then obtain approval of plan when calling district office prior to setting surface pipe.
6. Submit plugging report (CP-4) to K.C.C. after plugging is completed.
7. Obtain an approved injection docket number before disposing of salt water.
9. If an alternate 2 completion, cement in the production pipe from below any usable water to surface within 120 days of spud date.

**A Regular Section of Land
1 Mile = 5,280 Ft.**

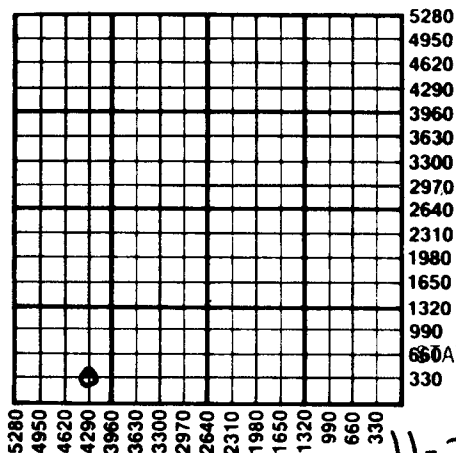

RECEIVED
STATE CORPORATION COMMISSION

NOV 2 1987
11-2-87
CONSERVATION DIVISION
Wichita, Kansas

State Corporation Commission of Kansas
Conservation Division
200 Colorado Derby Building
Wichita, Kansas 67202-1212
(316) 263-3238