



NOTICE OF INTENTION TO DRILL

(see rules on reverse side)

Starting Date Nov. 20, 1985 month day year

API Number 15- 135-20,648-80001

OPERATOR: License # 9860 Name Castle Resources Address R. R. 1, Box 90 City/State/Zip Hays, KS 67601 Contact Person Jerry Green Phone 913.625.9023

SE. NE. NE... Sec. 12 Twp. 18. S. Rg. 21 East West 4290 Ft. from South Line of Section 330 Ft. from East Line of Section

(Note: Locate well on Section Plat on reverse side)

CONTRACTOR: License # 5381 Name Big Springs Drilg. Inc. City/State Box 8287, Munger St., 400 N. Woodlawn #29 Wichita 67208

Nearest lease or unit boundary line 330 feet

County Ness Lease Name Elmore Ryan Well # L

Well Drilled For: Well Class: Type Equipment: X Oil SWD X Infield X Mud Rotary Gas Inj Pool Ext Air Rotary X OWWO Expl Wildcat Cable

Ground surface elevation feet MSL

Domestic well within 330 feet: yes no

Municipal well within one mile: yes no

Surface pipe by Alternate: 1 2 X

Depth to bottom of fresh water 75 feet

Depth to bottom of usable water 800 feet

Surface pipe diameter inches 336 in hole

Projected Total Depth 4200 feet

Formation

If OWWO: old well info as follows:

Operator Fourway Operating, Inc. Well Name Elmore #3 Comp Date 7-27-72 Old Total Depth 4200

I certify that well will comply with K.S.A. 55-101, et seq., plus eventually plugging hole to KCC specifications.

cementing will be done immediately upon setting production casing.

Date 11/12/85 Signature of Operator or Agent Elaine Jackson Title as agent

RETI/KOHE

For KCC Use:


Conductor Pipe Required feet; Minimum Surface Pipe Required feet per Alt. 1 2

This Authorization Expires 5-12-86 Approved By 11-12-85

RECEIVED
STATE CORPORATION COMMISSION
CT

Must be filed with the K.C.C. five (5) days prior to commencing well
This card void if drilling not started within six (6) months of date received by K.C.C.

NOV 12 1985
11-12-85
CONSERVATION DIVISION
Wichita, Kansas
A Regular Section of Land
1 Mile = 5,280 Ft.

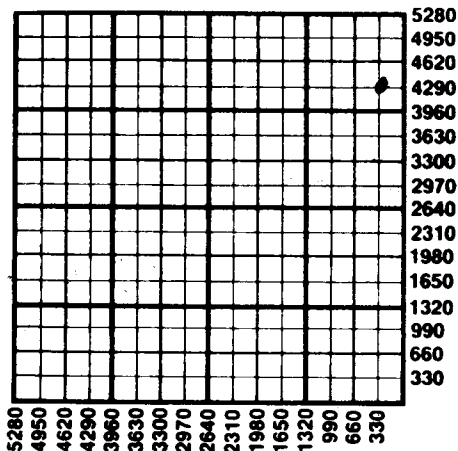

Important procedures to follow:

1. Notify District office before setting surface casing.
2. Set surface casing by circulating cement to the top.
3. File completion forms ACO-1 with K.C.C. within 90 days of well completion, following instructions on ACO-1, side 1, and including copies of wireline logs.
4. Notify District office 48 hours prior to old well workover or re-entry.
5. Prior to filing Intent, prepare a proposed plugging plan in case well is D & A, then obtain approval of plan when calling district office prior to setting surface pipe.
6. Submit plugging report (CP-4) to K.C.C. after plugging is completed.
7. Obtain an approved injection docket number before disposing of salt water.
8. Notify K.C.C. within 10 days when injection commences or terminates.
9. If an alternate 2 completion, cement in the production pipe from below any usable water to surface within 120 days of spud date.

State Corporation Commission of Kansas
Conservation Division
200 Colorado Derby Building
Wichita, Kansas 67202
(316) 263-3238