

CARD MUST BE TYPED

State of Kansas
NOTICE OF INTENTION TO DRILL

CARD MUST BE SIGNED

(see rules on reverse side)

Starting Date: August 29 1984
month day year

API Number 15- 007-21,909-00-00

OPERATOR: License # 5050

C SW NW Sec 6 Twp 32 S, Rge 10
(location) East West

Name Hummon Corporation

Address 400 One Main Place

City/State/Zip Wichita, KS 67202

Contact Person Wilber Berg

Phone 263-8521

3300 Ft North from Southeast Corner of Section

4620 Ft West from Southeast Corner of Section

(Note: Locate well on Section Plat on reverse side)

CONTRACTOR: License # 5148

Nearest lease or unit boundary line 660 feet

County Barber

Name Big-H Drilling, Inc.

Lease Name Herbert Well# 1

City/State Wichita, Kansas

Domestic well within 330 feet: yes no

Municipal well within one mile: yes no

Well Drilled For: Well Class: Type Equipment:

Oil Swd Infield Mud Rotary

Gas Inj Pool Ext. Air Rotary

OWWO Expl Wildcat Cable

Depth to Bottom of fresh water 100 feet

Lowest usable water formation Salt Plain Slt

Depth to Bottom of usable water 200 feet

Surface pipe by Alternate: 1 2

Surface pipe to be set 200 feet

Conductor pipe if any required

Ground surface elevation

This Authorization Expires 2-23-85

Approved By 8-23-84

If OWWO: old well info as follows:

Operator

Well Name

Comp Date Old Total Depth

Projected Total Depth 4000 feet

Projected Formation at TD Lansing

Expected Producing Formations

I certify that we will comply with K.S.A. 55-101, et seq., plus eventually plugging hole to K.C.C. specifications.

Date 8-22-84 Signature of Operator or Agent

Kenneth S. White


Agent

MHC/KOHE 8/23/84

Must be filed with the K.C.C. five (5) days prior to commencing well
This card void if drilling not started within six (6) months of date received by K.C.C.

Important procedures to follow :

**A Regular Section of Land
1 Mile = 5,280 Ft.**

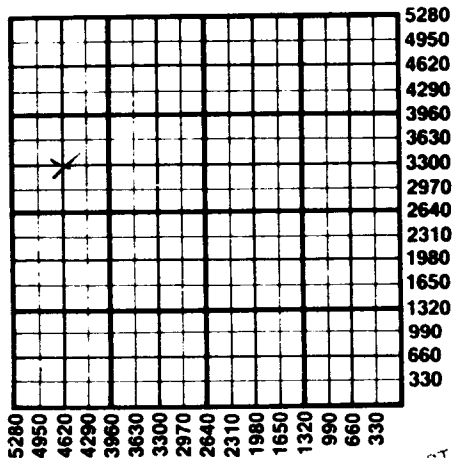

1. Notify District office before setting surface casing.
2. Set surface casing by circulating cement to the top.
3. File completion forms ACO-1 with K.C.C. within 90 days of well completion, following instructions on ACO-1, side 1, and including copies of wireline logs.
4. Notify District office 48 hours prior to old well workover or re-entry.
5. Prior to plugging, prepare a plugging plan, then obtain agreement from the appropriate district office for an approved plugging plan.
6. Submit plugging report (CP-4) to K.C.C. after plugging is completed.
7. Obtain an approved injection docket number before disposing of salt water.
8. Notify K.C.C. within 10 days when injection commences or terminates.
9. If an alternate completion, cement in the production pipe from below any surface water to surface within 120 days of spud date.

08-23-1984

RECEIVED
STATE CORPORATION COMMISSION

AUG 23 1984

CONSERVATION DIVISION
Wichita, Kansas

State Corporation Commission of Kansas
Conservation Division
200 Colorado Derby Building
Wichita, Kansas 67202
(316) 263-3238