

CARD MUST BE TYPED

State of Kansas

CARD MUST BE SIGNED

NOTICE OF INTENTION TO DRILL

(see rules on reverse side)

Expected Spud Date..... Dec. 7 1987
month day year

API Number 15-135-23,195-0000 VDF
C SE NW Sec. 28 Twp. 17 S, Rg. 23 East
3300 FSL West
3300 FEL Ft. from South Line of Section
Ft. from East Line of Section

OPERATOR: License # 3582
Name Primos-Kansas Energies
Address P. O. Box 2861
City/State/Zip Monroe, LA 71207
Contact Person Mike Mayne
Phone

(Note: Locate well on Section Plat on reverse side)
Nearest lease or unit boundary line 660 feet
County Ness
Lease Name Anspaugh Well # 1

CONTRACTOR: License # 5393
Name Abercrombie Drilling, Inc.
City/State Wichita, KS

Ground surface elevation - feet MSL
Domestic well within 330 feet: ___yes Xno
Municipal well within one mile: ___yes Xno
Depth to bottom of fresh water. 250'
Depth to bottom of usable water 750'
Surface pipe by Alternate: 1 ___ 2 X

Well Drilled For: Well Class: Type Equipment:
X Oil ___ Storage ___ Infield X Mud Rotary
___ Gas ___ Inj ___ Pool Ext. ___ Air Rotary
___ OWWO ___ Expl X Wildcat ___ Cable

Surface pipe planned to be set 300'
Conductor pipe required None
Projected Total Depth ___ feet
Formation Miss.

If OWWO: old well info as follows:

Operator
Well Name N/A
Comp Date Old Total Depth

I certify that well will comply with K.S.A. 55-101, et seq., plus eventually plugging hole to KCC specifications.

Date 12-3-87 Signature of Operator or Agent Jerry C. Langwehr Title Agent

For KCC Use:

Conductor Pipe Required ___ feet; Minimum Surface Pipe Required 200 feet per Alt. X (2)

This Authorization Expires 6-3-88 Approved By #12-3-87


EFFECTIVE DATE: 12-8-87

Must be filed with the K.C.C. five (5) days prior to commencing well
This card void if drilling not started within six (6) months of date received by K.C.C.

Important procedures to follow:

1. Notify District office before setting surface casing.
2. Set surface casing by circulating cement to the top.
3. File completion forms ACO-1 with K.C.C. within 120 days of well spud date, following instructions on ACO-1, side 1, and including copies of wireline logs.
4. Notify District office 48 hours prior to old well workover or re-entry.
5. Prior to filing Intent, prepare a proposed plugging plan in case well is D & A, then obtain approval of plan when calling district office prior to setting surface pipe.
6. Submit plugging report (CP-4) to K.C.C. after plugging is completed.
7. Obtain an approved injection docket number before disposing of salt water.
8. Notify K.C.C. within 10 days when injection commences or terminates.
9. If an alternate 2 completion, cement in the production pipe from below any usable water to surface within 120 days of spud date.

**A Regular Section of Land
1 Mile = 5,280 Ft.**

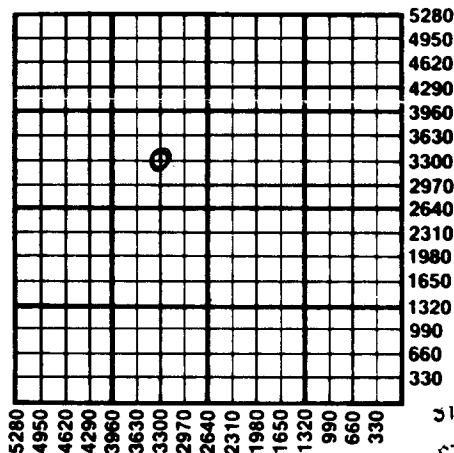

RECEIVED
STATE CORPORATION COMMISSION

DEC 3 1987
12-3-87
CONSERVATION DIVISION
Wichita, Kansas

State Corporation Commission of Kansas
Conservation Division
200 Colorado Derby Building
Wichita, Kansas 67202-1212
(316) 263-3238