

State of Kansas  
NOTICE OF INTENTION TO DRILL

(see rules on reverse side)

Expected Spud Date... August 30, 1988  
month day year

API Number 15-007-22,204-000  
APP SW NE

OPERATOR: License # 6769  
Name... Westmore Drilling Co.  
Address... Chapin Building Box 347  
City/State... Medicine Lodge, KS. 67104  
Contact Person... Gordon Penney  
Phone... 316-886-3112

Sec. 13 Twp. 32 S. Rg. 14 East  
West  
3165 Ft. from South Line of Section  
1760 Ft. from East Line of Section

(Note: Locate well on Section Plat on reverse side)

CONTRACTOR: License # 5380  
Name... Eagle Drilling, Inc.  
City/State... P.O. Box 12383 Wichita, KS. 67277-2383

Nearest lease or unit boundary line... 525 feet  
County... Barber  
Lease Name... Brook Well #... 1  
Ground surface elevation... 1802 feet MSL  
Domestic well within 330 feet: \_\_\_yes Xno  
Municipal well within one mile: \_\_\_yes Xno  
Depth to bottom of fresh water... 200  
Depth to bottom of usable water... 250  
Surface pipe by Alternate: 1 X 2 X  
Surface pipe planned to be set... 900+  
Conductor pipe required... No  
Projected Total Depth... 4600 feet  
Formation... Mississippi

Well Drilled For: Well Class: Type Equipment:  
X Oil \_\_\_ Storage \_\_\_ Infield X Mud Rotary  
\_\_\_ Gas \_\_\_ Inj \_\_\_ Pool Ext. \_\_\_ Air Rotary  
\_\_\_ OWWO \_\_\_ Expl \_\_\_ Wildcat \_\_\_ Cable

If OWWO: old well info as follows:

Operator .....  
Well Name .....  
Comp Date ..... Old Total Depth.....

I certify that well will comply with K.S.A. 55-101, et seq., plus eventually plugging hole to KCC specifications.

Date 8-29-88 Signature of Operator or Agent [Signature] Title Agent

For KCC Use:  
Conductor Pipe Required ..... feet; Minimum Surface Pipe Required 270' feet per Alt. (1) X  
This Authorization Expires 2-29-89 Approved By LKM 8-29-88


EFFECTIVE DATE: 9-3-88

Must be filed with the K.C.C. five (5) days prior to commencing well  
This card void if drilling not started within six (6) months of date received by K.C.C.

### Important procedures to follow:

1. Notify District office before setting surface casing.
  2. Set surface casing by circulating cement to the top.
  3. File completion forms ACO-1 with K.C.C. within 120 days of well spud date, following instructions on ACO-1, side 1, and including copies of wireline logs.
  4. Notify District office 48 hours prior to old well workover or re-entry.
  5. Prior to filing Intent, prepare a proposed plugging plan in case well is D & A, then obtain approval of plan when calling district office prior to setting surface pipe.
  6. Submit plugging report (CP-4) to K.C.C. after plugging is completed.
  7. Obtain an approved injection docket number before disposing of salt water.  
Notify K.C.C. within 10 days when injection commences or terminates.
- an alternate 2 completion, cement in the production pipe from below any usable water to surface within 120 days of spud date.

### A Regular Section of Land 1 Mile = 5,280 Ft.

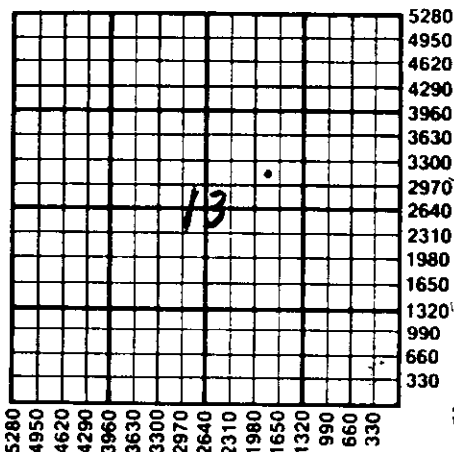

UG 29 1988  
8-29-88  
CONSERVATION DIVISION  
Wichita, Kansas

State Corporation Commission of Kansas  
Conservation Division  
200 Colorado Derby Building  
Wichita, Kansas 67202-1212  
(316) 263-3238