

STATE CORPORATION COMMISSION OF KANSAS
OIL & GAS CONSERVATION DIVISION
RECOMPLETION FORM
ACO-2 AMENDMENT TO WELL HISTORY

API NO. 15- 189-20,849 X 0001

County Stevens

C NW Sec 1 Twp 33S Rge 38 X East West

3960 Ft North from Southeast Corner of Section
3960 Ft West from Southeast Corner of Section

(Note: Locate well in section plat below)


Lease Name Fields "A" Well # 1H

Field Name Hugoton

Name of New Formation Chase

Elevation: Ground 3165 X NA

Section Plat

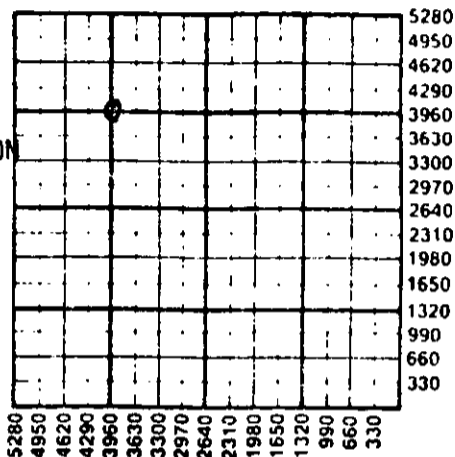

Operator: License # 5598
Name APX Corporation
Address P. O. Box 351

City/State/Zip Liberal, Kansas 67905-0351

Purchaser Panhandle Eastern Pipe Line Co.
(Transporter)

Operator Contact Person M. L. Pease
Phone (316) 624-6253

Designate Type of Original Completion
 New Well Re-Entry Workover

Oil SWD Temp Abd
 Gas Inj Delayed Comp
 Dry Other (Core, Water Supply, etc.)

Date of Original Completion: 5/14/85

DATE OF RECOMPLETION:

7/25/88 8/31/88

Commenced, 7/25/88 Completed 8/31/88

Designate Type of Recompletion/Workover:

Deepening Delayed Completion

Plug Back Re-perforation

Conversion to Injection/Disposal

Is recompleted production:

Commingled; Docket No. _____

Dual Completion; Docket No. _____

Other (Disposal or Injection)?

RECEIVED
STATE CORPORATION COMMISSION

DEC 22 1988

RECEIVED
CONSERVATION DIVISION
STATE CORPORATION COMMISSION

FEB 16 1989
02-116-89

RECEIVED
CONSERVATION DIVISION
Wichita, Kansas

K.C.C. OFFICE USE ONLY

F Letter of Confidentiality Attached
C Wireline Log Received
C Drillers Timelog Received

Distribution

KCC SWD/Rep NGPA
 KGS Plug Other
(Specify)

.....
.....
.....

12-28-88

INSTRUCTIONS: This form shall be completed in triplicate and filed with the Kansas Corporation Commission, 200 Colorado Derby Building, Wichita, Kansas 67202, within 120 days of the recompletion of any well. Rules 82-3-107 and 82-3-141 apply. Information on side two of this form will be held confidential for a period of 12 months if requested in writing and submitted with the form. See rule 82-3-107 for confidentiality in excess of 12 months. One copy of any additional wireline logs and driller's time logs (not previously submitted) shall be attached with this form. Submit ACO-4 prior to or with this form for approval of commingling or dual completions. Submit CP-4 with all plugged wells. Submit CP-111 with all temporarily abandoned wells. NOTE: Conversion of wells to either disposal or injection must receive approval before use; submit form U-1.

All requirements of the statutes, rules and regulations promulgated to regulate the oil and gas industry have been fully complied with and the statements herein are complete and correct to the best of my knowledge.

Signature M. L. Pease Title Division Production Mgr. Date 12/21/88
M. L. Pease

Subscribed and sworn to before me this 8th day of February 19 89

Notary Public Glenna S. Salley

Date Commission Expires
GLENN S. SALLEY
NOTARY PUBLIC
STATE OF KANSAS
MY APPT. EXPIRES 1-6-91 FORM ACO-2
5/88

