

Give All Information Completely
Make Required Affidavit
Mail or Deliver Report to:
Conservation Division
State Corporation Commission
211 No. Broadway
Wichita, Kansas

15-135-19174-00-00
WELL PLUGGING RECORD

Ness County, Sec. 36 Twp. 17 Rge. 23 (E) W (W)

Location as "NE/CNW/SW" or footage from lines C NE SW

Lease Owner Mull Drilling Co. Inc.

Lease Name Redetzke Well No. 1

Office Address 1625 Plaza Bldg. Wichita, Kansas

Character of Well (completed as Oil, Gas or Dry Hole) Dry hole.

Date well completed 2-17-63 19

Application for plugging filed 2-17-63 19

Application for plugging approved 2-17-63 19


Plugging commenced 11:00 A.M. 2-17-63 19

Plugging completed 11:00 A.M. 2-17-63 19

Reason for abandonment of well or producing formation Non productive.

If a producing well is abandoned, date of last production 19

Was permission obtained from the Conservation Division or its agents before plugging was commenced? Yes

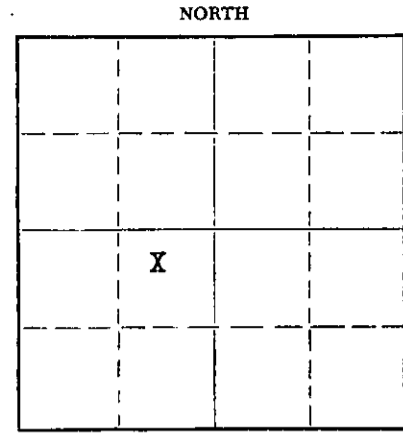

Locate well correctly on above Section Plat

Name of Conservation Agent who supervised plugging of this well Eldon Petty Hays, Kansas

Producing formation _____ Depth to top _____ Bottom _____ Total Depth of Well 4380' Feet

Show depth and thickness of all water, oil and gas formations.

OIL, GAS OR WATER RECORDS

CASING RECORD

FORMATION	CONTENT	FROM	TO	SIZE	PUT IN	PULLED OUT

Describe in detail the manner in which the well was plugged, indicating where the mud fluid was placed and the method or methods used in introducing it into the hole. If cement or other plugs were used, state the character of same and depth placed, from _____ feet to _____ feet for each plug set.

Hole plugged through drill pipe #1 plug at 400' and 25 sacks cement. # 2 plug at 200' with 20 sacks cement. # 3 plug at 40' with 10 sacks cement.


FEB 27 1965
2-27-63
CONSERVATION DIVISION
Wichita, Kansas

Name of Plugging Contractor Globe Cementing Co. (If additional description is necessary, use BACK of this sheet)
Address Great Bend, Kansas

STATE OF KANSAS, COUNTY OF SEDGWICK, ss.
Joseph O. Butts (employee of owner) or (owner or operator) of the above-described well, being first duly sworn on oath, says: That I have knowledge of the facts, statements, and matters herein contained and the log of the above-described well as filed and that the same are true and correct. So help me God.

(Signature) Joseph O. Butts
Wichita, Kansas (Address)

SUBSCRIBED AND SWORN TO before me this 19th day of February, 1963
My commission expires October 16, 1965
Notary Public.

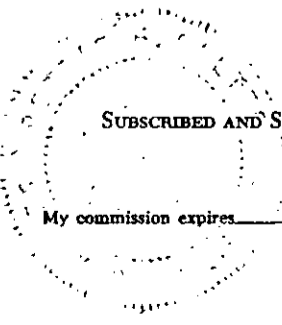

ROTARY DRILLERS' LOG

COMPANY: Mull Drilling Co., Inc.
Wichita, Kansas

ROTARY DRILLING COMMENCED: 2-8-63

CONTRACTOR: Mull Drilling Co., Inc.
Wichita, Kansas

ROTARY DRILLING COMPLETED: 2-18-63

CASING RECORD: 8 5/8" csg. cemented at 254'
w/ 165 sz.

LOCATION: #1 REDETZKE
C NE NW Section 36-17S-23W
Nowa County, Kansas

(Figures indicate bottom of formation - measurements from top of Rotary Bushing.)

35'	Surface soil and sand
254'	Shale & Clay
500'	Shale
780'	Red Bed
800'	Plains Lime
1260'	Shale
1585'	Red Bed & Shale
1625'	Anhydrite
1795'	Shale
2130'	Sandy Lime w/Shale
3585'	Lime & Shale
3706'	Sandy Lime w/Shale
4350'	Lime & Shale
4380'	Mississippi & Total Depth

RECEIVED
STATE CORPORATION COMMISSION

FEB 27 1963

CONSERVATION DIVISION
Wichita, Kansas

I hereby certify that this is a true and correct copy of the above log to the best of my knowledge.

MULL DRILLING COMPANY, INC.

Joseph B. Prungner, Jr.
Joseph B. Prungner, Jr.
Assistant Treasurer



SEDGWICK COUNTY OF KANSAS)
COUNTY OF SEDGWICK) SS

Subscribed and sworn to before me this 25th day of February, 1963.

Lola L. Foster
Lola L. Foster,
Notary Public

My commission expires: April 17, 1966.