


STATE OF KANSAS
STATE CORPORATION COMMISSION

WELL PLUGGING RECORD

Give All Information Completely
Make Required Affidavit
Mail or Deliver Report to
Conservation Division
State Corporation Comm.
245 North Water
Wichita, KS 67202

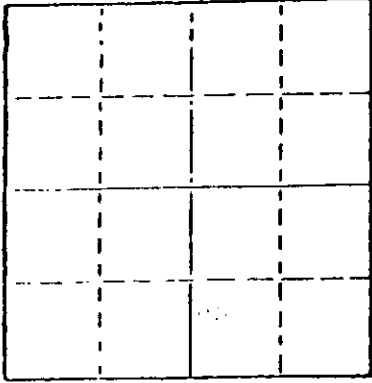

Locate well correctly on above
Section Plat

Ness County, Sec. 31 Twp. 17S Rge. 23W E/W
Location as "NE/CNW $\frac{1}{4}$ SW $\frac{1}{4}$ " or footage from lines
NE NE

Lease Owner Dunne-Gardner Petroleum, Inc.
Lease Name Horchem Well No. 1
Office Address Suite 250, 200 W. Douglas, Wichita, KS
Character of Well (Completed as Oil, Gas or Dry Hole) Dry hole

Date Well completed June 27, 1979
Application for plugging filed June 27, 1979
Application for plugging approved June 27, 1979
Plugging commenced June 27, 1979
Plugging completed June 27, 1979

Reason for abandonment of well or producing formation dry hole

If a producing well is abandoned, date of last production 19

Was permission obtained from the Conservation Division or its agents before plugging was commenced? yes

Name of Conservation Agent who supervised plugging of this well Marion Schmidt
Producing formation Depth to top Bottom Total Depth of Well 4500'
Show depth and thickness of all water, oil and gas formations.

OIL, GAS OR WATER RECORDS

CASING RECORD

FORMATION	CONTENT	FROM	TO	SIZE	PUT IN	PULLED OUT
				8-5/8"	321'	--

Describe in detail the manner in which the well was plugged, indicating where the mud fluid was placed and the method or methods used in introducing it into the hold. If cement or other plugs were used, state the character of same and depth placed, from feet to feet for each plug set.

- Mud to 600, 70 sacks cement
- Mud to 300, 20 sacks cement
- Mud to 40, plug, 10 sacks cement
- 5 sacks in rathole

RECEIVED
STATE CORPORATION COMMISSION
JUL - 6 1979
7-6-79
CONSERVATION DIVISION
Wichita, Kansas

(If additional description is necessary, use BACK of this sheet)

Name of Plugging Contractor

STATE OF KANSAS COUNTY OF SEDGWICK, ss.
Donald E. Hunt (owner or operator)
of the above-described well, being first duly sworn on oath, says: That I have knowledge of the facts, statements, and matters herein contained and the log of the above-described well as filed and that the same are true and correct. So help me God.

(Signature) Donald E. Hunt
Suite 250, 200 W. Douglas, Wichita, KS
(Address)

Sworn to before me this 5th day of July, 1979

Kathleen L. Durbin Notary Public.

My commission expires January 4, 1981

