

15-087-20624-0000

STATE OF KANSAS  
STATE CORPORATION COMMISSION

Form CP-4


Give All Information Completely  
Make Required Affidavit  
Mail or Deliver Report to:  
Conservation Division  
State Corporation Commission  
212 No. Market  
Wichita, Kansas

WELL PLUGGING RECORD

Barber County, Sec. 16 Twp. 32 Rge. (X) 14 (W)

Location as "NE/CNW%SW%" or footage from lines SW NE  
Lease Owner Aylward Drilling Company  
Lease Name Barkley Well No. 4  
Office Address 909 First National Bank Building  
Character of Well (completed as Oil, Gas or Dry Hole) Dry Hole  
Date well completed June 11 1978  
Application for plugging filed June 11 1978  
Application for plugging approved June 11 1978  
Plugging commenced June 11 1978  
Plugging completed June 11 1978  
Reason for abandonment of well or producing formation Lost Hole

NORTH

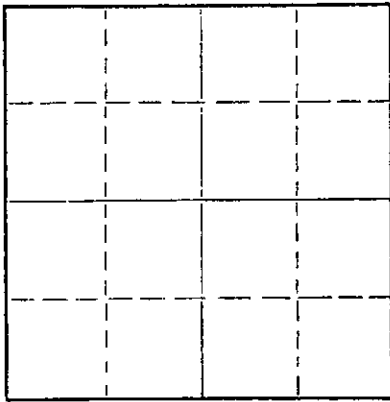

Locate well correctly on above  
Section Plat

If a producing well is abandoned, date of last production 19  
Was permission obtained from the Conservation Division or its agents before plugging was commenced? Yes

Name of Conservation Agent who supervised plugging of this well Bill Owens  
Producing formation \_\_\_\_\_ Depth to top \_\_\_\_\_ Bottom \_\_\_\_\_ Total Depth of Well 795 Feet  
Show depth and thickness of all water, oil and gas formations.

OIL, GAS OR WATER RECORDS

CASING RECORD

FORMATION	CONTENT	FROM	TO	SIZE	PUT IN	PULLED OUT
	Surface					
	Casing	0	307	8 5/8"	307	None

Describe in detail the manner in which the well was plugged, indicating where the mud fluid was placed and the method or methods used in introducing it into the hole. If cement or other plugs were used, state the character of same and depth placed, from \_\_\_\_\_ feet to \_\_\_\_\_ feet for each plug set.

Set first plug @ 300' with 20 sacks cement and 2 sacks of hulls, second plug @ 40' with 12 sacks of cement and 1/2 sack of hulls, and 3 sacks of cement in rat hole. Job completed at 11 p.m., June 11, 1978.

RECEIVED  
STATE CORPORATION COMMISSION  
JUN 14 1978  
6-14-78  
CONSERVATION DIVISION  
Wichita, Kansas

(If additional description is necessary, use BACK of this sheet)

Name of Plugging Contractor Abercrombie Drilling, Inc.  
Address 801 Union Center, Wichita, Kansas

STATE OF Kansas, COUNTY OF Sedgwick, ss.  
Frank Hamlin (employee of owner) or (owner or operator) of the above-described well, being first duly sworn on oath, says: That I have knowledge of the facts, statements, and matters herein contained and the log of the above-described well as filed and that the same are true and correct. So help me God.


(Signature) Frank Hamlin

(Address)

SUBSCRIBED AND SWORN to before me this 13th day of June, 1978

Norma Stoddard  
Notary Public.

My Commission expires April 1, 1979

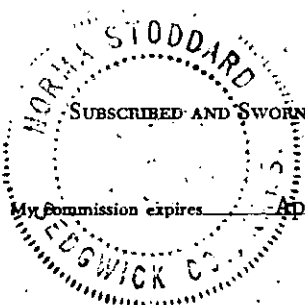

OPERATOR:  
CONTRACTOR:  
WELL NAME:  
LOCATION:  
  
SPUD DATE:  
COMPLETION DATE:

Aylward Drilling Company  
Abercrombie Drilling, Inc.  
Barkley Estate #4  
SW NE Section 16-32S-14W  
Barber County, Kansas  
June 10, 1978  
June 11, 1978

0	307	Gyp. rock & red bed
307	795	Red bed, shells & shale
	795	Rotary Total Depth

Spud hole at 6:00 p.m., June 10, 1978. Drilled 307' of 12 1/4" hole. Ran 10 joints of 24# 8-5/8" surface casing. Set at 307' with 225 sacks common cement, 2% gel, 3% CaCl. Plug was down at 12:00 midnight, June 10, 1978. Cement did circulate.

T.D. 795'. Lost circulation. Set first plug at 300' with 20 sacks cement, 2 sacks hulls, second plug at 40' with 12 sacks cement, 1/2 sack hulls, third plug in rathole with 3 sacks of cement. Plug was down at 11:00 p.m., June 11, 1978. State plugger Bill Owens.

STATE OF KANSAS )  
                          ) ss  
COUNTY OF SEDGWICK )

Jack L. Partridge, Assistant Secretary-Treasurer of Abercrombie Drilling, Inc., does hereby state that the above and foregoing is a true and correct copy of the log of the Barkley Estate #4, SW NE Section 16-32S-14W, Barber County, Kansas.

ABERCROMBIE DRILLING, INC.

BY Jack L. Partridge  
Jack L. Partridge,  
Assistant Secretary-Treasurer

Subscribed and sworn to before me, a Notary Public, in and for the county and state aforesaid, as of this 28th day of June, 1978.

My commission expires July 21, 1979

Sandra Richman  
Sandra Richman, Notary Public

