


STATE OF KANSAS
STATE CORPORATION COMMISSION
CONSERVATION DIVISION
P. O. BOX 17027
WICHITA, KANSAS 67217

FORM CP-4

WELL PLUGGING RECORD

Ness County, Sec. 23 Twp. 16S Rge. 26W (E) (W)

Location as "NE/CNWSW" or footage from lines C SW NW
Lease Owner PICKRELL DRILLING COMPANY
Lease Name BOYD "H" Well No. 1
Office Address SUITE 205, LITWIN BLDG. WICHITA, KS. 67202
Character of Well (completed as Oil, Gas or Dry Hole) Dry Hole
Date well completed 2-15 19 76
Application for plugging filed 2-15 19 76
Application for plugging approved 2-15 19 76
Plugging commenced 2-15 19 76
Plugging completed 2-15 19 76
Reason for abandonment of well or producing formation Dry Hole

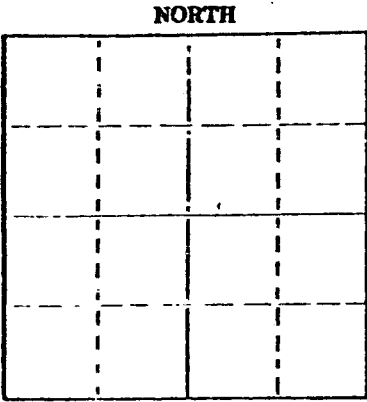

Locate well correctly on above Section Plat

If a producing well is abandoned, date of last production 19
Was permission obtained from the Conservation Division or its agents before plugging was commenced? Yes

Name of Conservation Agent who supervised plugging of this well Leo Massey
Producing formation _____ Depth to top _____ Bottom _____ Total Depth of Well 4587
Show depth and thickness of all water, oil and gas formations.

OIL, GAS OR WATER RECORDS

CASING RECORD

FORMATION	CONTENT	FROM	TO	SIZE	PUT IN	PULLED OUT
				8 5/8	215	None

Describe in detail the manner in which the well was plugged, indicating where the mud fluid was placed and the method or methods used in introducing it into the hole. If cement or other plugs were used, state the character of same and depth placed, from _____ feet to _____ feet for each plug set.

70 sacks at 720'
20 sacks at 185'
10 sacks at 40' (bridged)

4-5-76

Name of Plugging Contractor PICKRELL DRILLING COMPANY
Address SUITE 205, LITWIN BLDG., WICHITA, KS. 67202

STATE OF Kansas COUNTY OF Sedgwick
C. W. Sebitts (employee of owner) or (owner or operator) of the above-described

well, being first duly sworn on oath, says: That I have knowledge of the facts, statements and matters herein contained and the log of the above-described well as filed and that the same are true and correct. So help me God

(Signature) C. W. Sebitts
Suite 205, Litwin Bldg., Wichita, Ks. 02
(Address)

SUBSCRIBED AND SWORN TO before me this 23 day of March 19 76

My commission expires _____
Jo Ann Sarver Notary Public



ROTARY DRILLING LOG

15-135-21158 0000

COMPANY: PICKRELL DRILLING COMPANY
SUITE 205, LITWIN BLDG.
WICHITA, KS. 67202
LOCATION: Boyd "H" #1
C SW NW Sec. 23-16S-26W
Ness Co., Kansas
CONTRACTOR: PICKRELL DRILLING COMPANY
Wichita, Kansas

Rotary Drilling Commenced 2-5-76
Rotary Drilling Completed 2-15-76

CASING RECORD: 8 5/8" surface pipe set at 215' with 160 sacks cement. Comp. 2-5-76.

LOG

(Figures indicate bottom of formation — measurements from top of rotary bushing.)

Shale	217
Shale	760
Sand	825
Shale	915
Shale	1530
Sand	1755
Shale	1820
Shale	2020
Shale	2061
Shale	2090
Shale & Lime	2570
Shale & Lime	2723
Lime & Shale	2835
Lime & Shale	2970
Shale & Lime	3100
Shale & Lime	3240
Lime & Shale	3345
Lime & Shale	3460
Shale & Lime	3585
Shale & Lime	3624
Shale & Lime	3800
Shale & Lime	3950
Lime	3990
Lime & Shale	4100
Lime	4215
Lime	4295
Lime & Shale	4365
Lime	4440
Lime	4508
Lime & Shale	4555
Lime	4570
Miss.-Lime	4587

The undersigned, C. W. Sebitts, Attorney-in-Fact for PICKRELL DRILLING COMPANY, hereby certifies in behalf of said Company, that the above is a true and correct log of the formation encountered in drilling the above well as reflected by the Daily Drilling Reports.

PICKRELL DRILLING COMPANY

By C. W. Sebitts Attorney-in-Fact


STATE OF KANSAS }
COUNTY OF SEDGWICK } ss.:

On this 23 day of March, 19 76, before me the undersigned, a Notary Public, in and for

the County and State aforesaid, personally appeared C. W. Sebitts, to me known to be the identical person who subscribed the name of PICKRELL DRILLING COMPANY to the foregoing instrument as its Attorney-in-Fact and acknowledged to me that he executed the same as his free and voluntary act and deed, and as the free and voluntary act and deed of such company, for the uses and purposes therein set forth.

Given under my hand and seal of office the day and year last above written.

My commission expires:

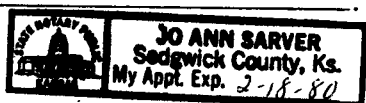

Jo Ann Sarver
Notary Public
Jo Ann Sarver