


WELL PLUGGING RECORD

Give All Information Completely
Make Required Affidavit
Mail or Deliver Report to:
Conservation Division
State Corporation Commission
211 No. Broadway
Wichita, Kansas

Barber _____ County. Sec. 10 Twp. 32S Rge. 10W (E) _____ (W)
Location as "NE/CNW/SW" or footage from lines c NE SE
Lease Owner Faulconer & McCoy
Lease Name _____ Dohm _____ Well No. 1
Office Address 336 Union Center, Wichita, Kansas 67202
Character of Well (completed as Oil, Gas or Dry Hole) Dry Hole
Date well completed _____ December 5 19 66
Application for plugging filed _____ December 5 19 66
Application for plugging approved _____ December 5 19 66
Plugging commenced _____ December 5 19 66
Plugging completed _____ December 5 19 66
Reason for abandonment of well or producing formation Dry Hole

NORTH

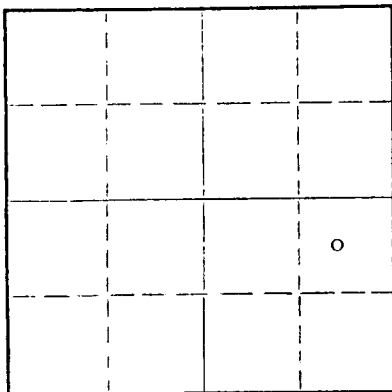

Locate well correctly on above Section Plat

If a producing well is abandoned, date of last production _____ 19 _____
Was permission obtained from the Conservation Division or its agents before plugging was commenced? Yes

Name of Conservation Agent who supervised plugging of this well Archie V. Elving, Pratt, Kansas
Producing formation _____ Depth to top _____ Bottom _____ Total Depth of Well 4398 Feet
Show depth and thickness of all water, oil and gas formations.

OIL, GAS OR WATER RECORDS

CASING RECORD

FORMATION	CONTENT	FROM	TO	SIZE	PUT IN	PULLED OUT
		0	216'	8 5/8"	216'	None

Describe in detail the manner in which the well was plugged, indicating where the mud fluid was placed and the method or methods used in introducing it into the hole. If cement or other plugs were used, state the character of same and depth placed, from _____ feet to _____ feet for each plug set.

Set Plug: 200'/25 sacks cement
40'/10 sacks cement
2 sacks cement in rat hole

RECEIVED
CONSERVATION COMMISSION
DEC 8 1966
CONSERVATION DIVISION
12-08-1966

(If additional description is necessary, use BACK of this sheet)
Name of Plugging Contractor Hellar Drilling Company, Inc.
Address 1014 Union Center Wichita, Kansas

STATE OF Kansas, COUNTY OF Sedgwick, ss.
D.L. Hellar, Pres. of Hellar Drilling Company, (Employee of owner) or (owner or operator) of the above-described well, being first duly sworn on oath, says: That I have knowledge of the facts, statements, and matters herein contained and the log of the above-described well as filed and that the same are true and correct. So help me God.

(Signature) [Signature] D. L. Hellar, President
1014 Union Center, Wichita, Kansas 67202
(Address)

SUBSCRIBED AND SWORN TO before me this 7th day of December, 19 66

[Signature]
Catherine Darcey - Notary Public.

My commission expires March 25, 1968

15-007-30271-00-00

DRILLER'S LOG

COMPANY: Faulconer & McCoy, 336 Union Center, Wichita, Kansas
 CONTRACTOR: Hellar Drilling Company, Inc., Wichita, Kansas
 LEASE: #1 Dohm
 LOCATION: c NE SE 10-32S-10W, Barber County, Kansas
 COMMENCED: November 25, 1966
 COMPLETED: December 5, 1966
 CASING: Set 8 5/8" surface casing @ 216'/200 sacks cement

0-216	Surface Sand & Red Bed
216-790	Shale
790-1300	Shale & shells
1300-1540	Salt Section & Anhydrite - stringers
1540-1707	Salt & Anhydrite
1707-1825	Cherty Lime
1825-2037	Shale & Lime
2037-2197	Lime & Shale
2197-2443	Shale & Lime
2443-2604	Shale & Lime Stks.
2604-3093	Shale & Lime
3093-3278	Lime & Shale
3278-3545	Shale & Lime
3545-3663	Douglas shale section
3663-3721	L.-K.C. Lime
3721-3805	Lime
3805-3917	K.C. Lime
3917-4089	Lime
4089-4137	K.C. Lime
4137-4336	Lime & Shale
4336-4383	Lime & Chert
4383-4398	Chert
4398	Rotary Total Depth

RECORDED
 INDEXED
 CONSERVATION COMMISSION
 DEC 8 1966
 CONSERVATION DIVISION
 WICHITA, KANSAS
 12-08-1966

D & A

STATE OF KANSAS)
) SS
 COUNTY OF SEDGWICK)

I, D. L. Hellar, do hereby certify that the above and foregoing is a true and correct copy of the log of the #1 Dohm, located in c NE SE Sec. 10-32S-10W, Barber County, Kansas, as reflected by the files of the Hellar Drilling Company, Inc.

HELLAR DRILLING COMPANY, INC.

By *D. L. Hellar*
 President - D. L. Hellar

Subscribed and sworn to before me, a Notary Public, in and for Sedgwick County, Kansas, this 7th day of December, 1966.

Catherine Darcey
 Notary Public - Catherine Darcey

My Commission Expires:
 March 25, 1968.