


STATE OF KANSAS
STATE CORPORATION COMMISSION

Give All Information Completely
Make Required Affidavit
Mail or Deliver Report to
Conservation Division
State Corporation Commission

P. O. Box 17027
Wichita, Kansas 67217

WELL PLUGGING RECORD

Barber County, Sec. 14 Twp. 32 Rge. 14 (E) W (W)
Location as "NE/CNW/SE/SW" or footage from lines SE SW NW
Lease Owner Bowers Drig. Co., Inc.
Lease Name Block B Well No. 42
Office Address Suite 1425, 125 N. Market, Wichita, Kans.
Character of Well (completed as Oil, Gas or Dry Hole) _____
Date well completed _____ 19____
Application for plugging filed February 19 74
Application for plugging approved February 19 74
Plugging commenced February 8 19 74
Plugging completed February 12 19 74
Reason for abandonment of well or producing formation _____

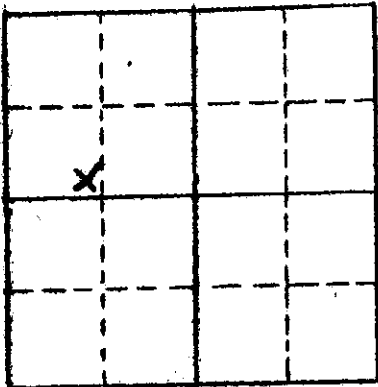

If a producing well is abandoned, date of last production _____ 19____
Was permission obtained from the Conservation Division or its agents before plugging was commenced? Yes

Name of Conservation Agent who supervised plugging of this well Russell Bibierstein
Producing formation _____ Depth to top _____ Bottom _____ Total Depth of Well _____ Feet
Show depth and thickness of all water, oil and gas formations.

OIL, GAS OR WATER RECORDS

CASING RECORD

FORMATION	CONTENT	FROM	TO	SIZE	PUT IN	PULLED OUT
				8 5/8"	905	None
				4 1/2"	4440	4000

Describe in detail the manner in which the well was plugged, indicating where the mud fluid was placed and the method or methods used in introducing it into the hole. If cement or other plugs were used, state the character of same and depth placed, from _____ feet to _____ feet for each plug set.

February 8, 1974 Plugged off bottom. Dumped sand to 4300'. Mixed and dumped 4 ex of cement.
February 12, 1974 Plugged off top. Set 10' rock bridge at 250'. Filled 8 5/8" surface casing from 250' to base of cellar with 3000 lb. P.S.I. ready-mix concrete.

RECEIVED
STATE CORPORATION COMMISSION
JUL 26 1974
7-26-74
CONSERVATION DIVISION
Wichita, Kansas

(If additional description is necessary, use BACK of this sheet)
Name of Plugging Contractor RUSS CASING PULLING, INC.
Address P. O. Box 1082, Grant Bend, Kansas 67530

STATE OF Kansas COUNTY OF Adair ss.
Emil E. Bowers (employed by owner) or (owner or operator) of the above-described well, being first duly sworn on oath, says: That I have knowledge of the facts, statements, and matters herein contained and the log of the above-described well as filed and that the same are true and correct. So help me God.
(Signature) Emil E. Bowers

Subscribed and Sworn to before me this 25th day of July 19 74
(Address) _____
Carol A. Neal
Notary Public.

My commission expires May 12, 1977

DRILLER'S LOG

COMPANY: Bowers Drilling Company, Inc., 125 N. Market - Suite 1425, Wichita, Kansas 67202
 CONTRACTOR: Hellar Drilling Company, Inc., 339 Union Center Bldg., Wichita, Kansas 67202
 LEASE: #2 Elsea "B"
 LOCATION: SE SW NW 14-32S-14W, Barber County, Kansas
 COMMENCED: October 3, 1973
 COMPLETED: October 19, 1973
 CASING: Set 8 5/8" Surface Casing @ 914' w/500 sacks cement
 Set 4 1/2" Casing @ 4439' w/75 sacks cement

0-715	Surface Soil & Red Bed
715-855	Red Bed
855-1185	Red Bed & Shale
1185-1950	Red Bed & Shale & Salt
1950-2415	Lime & Shale
2415-2620	Lime w/Shale Streaks
2620-2829	Lime w/Shale
2829-3968	Lime & Shale
3968-4126	Lime (L.K.C.)
4126-4145	Lime - Chalk
4145-4156	Lime (L.K.C.)
4156-4399	Lime
4399-4440	Miss.
4440	Rotary Total Depth

RECEIVED
 STATE CORPORATION COMMISSION
 APR 5 - 1974
 4-5-74
 CONSERVATION DIVISION
 Wichita, Kansas

STATE OF KANSAS)
) SS
 COUNTY OF SEDGWICK)

I, D. L. Hellar, do hereby certify that the above and foregoing is a true and correct copy of the log of the #2 Elsea "B", located in SE SW NW 14-32S-14W, Barber County, Kansas, as reflected by the files of the Hellar Drilling Company, Inc.

HELLAR DRILLING COMPANY, INC.

By *D. L. Hellar*
 President - D. L. Hellar

Subscribed and sworn to before me, a Notary Public, in and for Sedgwick County, Kansas, this 23th day of October, 1973.

Catherine Darcey
 Notary Public - Catherine Darcey

My Commission Expires:
 March 25, 1976.