


STATE OF KANSAS
STATE CORPORATION COMMISSION

WELL PLUGGING RECORD

Give All Information Completely
Make Required Affidavit
Mail or Deliver Report to
Conservation Division
State Corporation Comm.
245 North Water
Wichita, KS 67202

Barber County, Sec. 10 Twp 32S Rge. 14W XE/W
Location as "NE/CNW 1/4 SW 1/4" or footage from lines
990' EEL, 1650' FSL (SW NE SE)
Lease Owner Mull Drilling Company, Inc.
Lease Name Barkley 'C' Well No. #1
Office Address P.O. Box 2758, Wichita, KS 67201
Character of Well (Completed as Oil, Gas or Dry Hole)

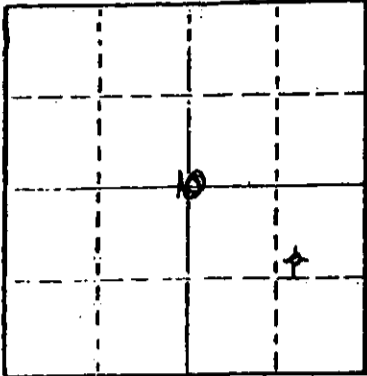

Locate well correctly on above
Section Plat

Dry hole Plugged and abandoned.
Date Well completed May 8, 1959 19
Application for plugging filed 19
Application for plugging approved May 8, 1959 19
Plugging commenced May 8, 1959 19
Plugging completed May 9, 1959 19
Reason for abandonment of well or producing formation
Dry hole
If a producing well is abandoned, date of last production 19

Was permission obtained from the Conservation Division or its agents before plugging was commenced? Yes

Name of Conservation Agent who supervised plugging of this well Archie Irving, KCC
Producing formation NA Depth to top NA Bottom NA Total Depth of Well 4510'
Show depth and thickness of all water, oil and gas formations.

OIL, GAS OR WATER RECORDS

CASING RECORD

FORMATION	CONTENT	FROM	TO	SIZE	PUT IN	PULLED OUT
				8-5/8"	230' w/140 sx	

Describe in detail the manner in which the well was plugged, indicating where the mud fluid was placed and the method or methods used in introducing it into the hold. If cement or other plugs were used, state the character of same and depth placed, from _____ feet to _____ feet for each plug set.

Well plugged May 8, 1959 by Mull Drilling Company (Wayne Kirkman, Globe Cementing was cementing company)
10 sx on top
25 sx on bottom
P&A 5/8/59

(If additional description is necessary, use BACK of this sheet)

Name of Plugging Contractor Mull Drilling Company, Inc.

STATE OF KANSAS COUNTY OF SEDGWICK, ss.
Michael R. Kidwell (employee of owner) or ~~(owner)~~
of the above-described well, being first duly sworn on oath, says: That I have knowledge of the facts, statements, and matters herein contained and the log of the above-described well as filed and that the same are true and correct. So help me God.

(Signature) Michael R. Kidwell, Geol. Mngt.
P.O. Box 2758, Wichita, KS 67201
(Address)

SUBSCRIBED AND SWORN TO before me this 18th day of August, 19 83

Patricia L. Ungleich
Notary Public.

My commission expires March 27, 1987

Patricia L. Ungleich

RECEIVED
STATE CORPORATION COMMISSION
AUG 23 1983
8-23-83
CONSERVATION DIVISION
Wichita, Kansas

PATRICIA L. UNGLEICH
STATE NOTARY PUBLIC
Sedgwick County, Kansas
My Appt. Exp. 3/27/87