

15-007-00434-00-01


STATE OF KANSAS  
STATE CORPORATION COMMISSION

WELL PLUGGING RECORD

Give All Information Completely  
Make Required Affidavit  
Mail or Deliver Report to:  
Conservation Division  
State Corporation Commission  
800 Bitting Building  
Wichita, Kansas

Barber County, Sec. 6 Twp. 32 Rge. (E) 14 (W)

Location as "NE/CNW $\frac{1}{4}$ SW $\frac{1}{4}$ " or footage from lines Center NE  $\frac{1}{4}$   
Lease Owner Isern Drilling Company  
Lease Name Ely-Little Well No. 1  
Office Address Ellinwood, Kansas  
Character of Well (completed as Oil, Gas or Dry Hole) Dry hole  
Date well completed 7-10-53  
Application for plugging filed 7-11-53  
Application for plugging approved 7-13-53  
Plugging commenced July 18, 1953  
Plugging completed July 23, 1953  
Reason for abandonment of well or producing formation dry hole

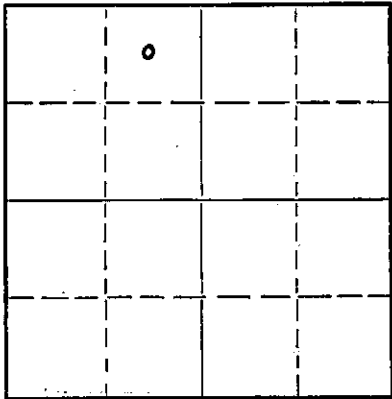

Locate well correctly on above  
Section Plat

If a producing well is abandoned, date of last production none  
Was permission obtained from the Conservation Division or its agents before plugging was commenced? yes

Name of Conservation Agent who supervised plugging of this well M. A. Rives  
Producing formation None Depth to top Bottom Total Depth of Well Feet  
Show depth and thickness of all water, oil and gas formations.

OIL, GAS OR WATER RECORDS

CASING RECORD

Formation	Content	From	To	Size	Put In	Pulled Out
				13" OD	307'	None
				5-1/2"	4981'	3772'

Describe in detail the manner in which the well was plugged, indicating where the mud fluid was placed and the method or methods used in introducing it into the hole. If cement or other plugs were used, state the character of same and depth placed, from feet to feet for each plug set.

Ran 5 sacks of cement at 4097'. Mudded hole to 300', set a 20' rock bridge to 280' and ran 30 sacks of cement at 280'. Mudded hole to 35', set rock bridge to 15' and ran 10 sacks of cement on top. Plugging completed.

RECEIVED  
STATE CORPORATION COMMISSION

AUG 11 1953  
8-11-53

Name of Plugging Contractor West Supply Company  
Address Chase, Kansas

CONSERVATION DIVISION  
Wichita, Kansas

STATE OF KANSAS, COUNTY OF BARTON, ss.  
W. F. Banks (employee of owner) or (owner) of the above-described well,  
being first duly sworn on oath, says: That I have knowledge of the facts, statements, and matters herein contained and the log of the above-described well as filed and that the same are true and correct. So help me God.

(Signature) W. F. Banks  
Ellinwood, Kansas (Address)

SUBSCRIBED AND SWORN to before me this 8th day of August, 1953.

George Meyer  
Notary Public

My commission expires Feb. 10, 1955.

PLUGGING  
F&I SEC 6 T 32 R 14 W  
PAGE 113 LINE 37

WELL LOG

Isern Drilling Company, Owner- Ely-Lytle #1  
Cen. NE/4 NW/4 Section 6, Township 32, Range 11W,  
Barber County, Kans.

Elevation: 1860 DF

WASH DOWN JOB ON OLD DRY HOLE

Pipe record:

13 3/8" set at 307'  
5 1/2" set at 4981'

Washed down hole to old total depth 4982'  
Set and cemented 5 1/2" 15 1/2# casing at 4981'

Job commenced 6-29-53  
Completed 7-10-53

Perforated Simpson sand 4841-4845  
No shows, swabbed 35 bbls water per hour.

Perforated Douglas sand 4060-4068  
No shows, swabbed 10 bbls water per hour.

PB TD 4100 D&A

State of Kansas )  
County of Barton ) SS

I, W. F. Banks, Production Superintendent for Isern Drilling Company,  
being first duly sworn on oath, declares: That I have knowledge of the  
facts, statements and matters herein contained pertaining to the log of  
the above-described well, as filed, and that the same are true and correct.

W. F. Banks

Subscribed and Sworn to before me this 11th day of August, 1953.

George A. Meyer  
Notary Public

My commission expires Feb. 10, 1955.

RECEIVED  
STATE CORPORATION COMMISSION

AUG 13 1953  
8-13-53  
CONSERVATION DIVISION  
Wichita, Kansas

PLUGGING  
FILE SEC 6 T 32 R 14W  
BOOK PAGE 113 LINE 37