

STATE OF KANSAS  
STATE CORPORATION COMMISSION

Give All Information Completely  
Make Required Affidavit  
Mail or Deliver Report to:  
Conservation Division  
State Corporation Commission  
800 Bitting Building  
Wichita, Kansas

WELL PLUGGING RECORD  
OR  
FORMATION PLUGGING RECORD

Strike out upper line  
when reporting plug-  
ging off formations.

Barber County, Sec. 6 Twp. 32S Rge. (E) 14 (W)

Location as "NE 1/4 NW 1/4 SW 1/4" or footage from lines 630' from N. & 1980' from W. lines

Lease Owner The Carter Oil Company

Lease Name Lytle C-61 Well No. 1

Office Address P. O. Box 431 - Ponca City, Oklahoma

Character of Well (Completed as Oil, Gas or Dry Hole) Dry Hole

Date, well completed March 25 1938

Application for plugging filed March 26 1938

Application for plugging approved March 26 1938


Plugging Commenced March 26 1938

Plugging Completed March 26 1938

Reason for abandonment of well or producing formation Dry Hole

If a producing well is abandoned, date of last production None 193

Was permission obtained from the Conservation Division or its agents before plugging was commenced? Yes

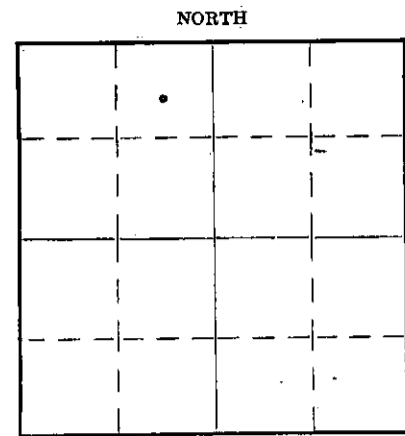

Locate well correctly on above  
Section Plat

Name of Conservation Agent who supervised plugging of this well Ed Shiel

Producing formation Arbuckle - Dry Depth to top 4953 Bottom 4980 Total Depth of Well 4980 Feet.

Show depth and thickness of all water, oil and gas formations.

OIL, GAS OR WATER RECORDS


CASING RECORD

Formation	Content	From	To	Size	Put In	Pulled Out
Arbuckle	Dry	4953	4980	12 1/2"	291'	None

Describe in detail the manner in which the well was plugged, indicating where the mud fluid was placed and the method or methods used in introducing it into the hole. If cement or other plugs were used, state the character of same and depth placed, from.....feet to.....feet for each plug set.

Filled hole with heavy mud from 4980' to 350'. Put in 20 sacks of cement and then plugged in top of hole with 30 sacks of cement.

PLUGGING  
FILE SEC. 6-T-32R-141  
BOOK PAGE 14 LINE 8

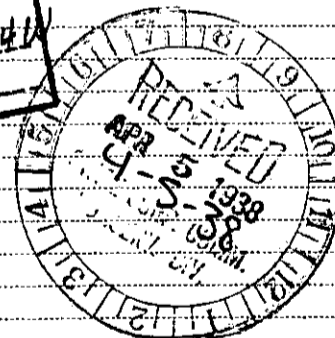

(If additional description is necessary, use BACK of this sheet)

Correspondence regarding this well should be addressed to W. B. Crutcher  
Address P. O. Box 431 - Ponca City, Oklahoma

STATE OF Oklahoma COUNTY OF Kay, SS.

(employee of owner) or (owner or operator) of the above-described well,  
being first duly sworn on oath, says: That I have knowledge of the facts, statements, and matters herein contained and the log of the above-described well as filed and that the same are true and correct. So help me God.

(Signature) W. B. Crutcher

P. O. Box 431 - Ponca City, Oklahoma  
(Address)

SUBSCRIBED AND SWORN TO before me this 14 day of April, 1938.



My commission expires

November 22, 1941

William E. Richard  
Notary Public.

## FORMATION RECORD

FORMATION	FROM	REMARKS
Cellar	14	
Red Bed	310	Set 291' of 12 $\frac{1}{2}$ " at 307 w/ 250 Quickard
Red Bed, Gyp Rock	790	
Red Bed, Shale, Shells	1230	SHT 900 - 1160 OK
Salt, Shale, Shells	1380	
Shale, Shells	1530	SHT 1400 - OK
Salt, Shale	1630	SHT 1650 - OK
Salt	1670	
Shale	1710	
Shale, Shells, Salt	1770	
Lime	1790	
Shale, Shells	1968	SHT 1900 - OK
Lime	2018	
Broken Lime, Shale	2080	
Broken Lime	2142	
Lime	2275	SHT 2150 - 2160 OK
Shale	2281	
Broken Lime, Shale	2305	
Broken Lime	2320	
Shale	2330	
Broken Lime	2358	
Lime	2430	SHT 2410 OK
Chert	2448	
Lime, Chert	2463	
Lime	2487	
Shale	2495	
Broken Lime, Shale	2519	
Broken Lime	2525	
Shale	2534	
Cherty Lime	2547	
Broken Lime	2580	
Shale, Chert, Shells	2590	
Lime	2595	
Shale	2615	SHT 2655 - OK
Broken Lime, Shale	2682	
Shale	2692	
Lime	2707	
Shale	2715	
Lime	2735	
Shale	2746	
Broken Lime, Shale	2769	
Broken Lime	2784	
Shale	2800	
Lime	2810	
Sandy Lime	2816	
Broken Lime	2828	
Shale, Shells	2903	
Shale	2907	
Shale, Shells	2948	
Shale	2981	
Broken Shale, Lime	3024	SHT 3000 - OK

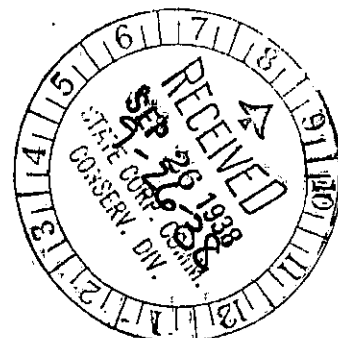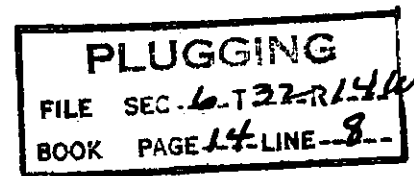


Lytle C-61 #1 15-007-00434-0000  
 NW & W NE & SE NE 6-32S-14W  
 Barber County, Kansas

**FORMATION RECORD**

<u>FORMATION</u>	<u>FROM</u>	<u>REMARKS</u>
Shale	3035	
Chert	3039	
Shale	3063	
Shale, Shells	3109	
Shale	3195	
Broken Lime	3203	
Shale	3210	
Lime	3322	SHT 3250 - OK
Broken Lime	3366	
Lime	3410	
Shale	3445	
Lime	3535	SHT 3500 - OK
Shale	3585	
Broken Lime, Shale	3620	
Lime	3700	
Shale	3715	
Broken Lime, Shale	3740	
Shale	3750	
Broken Lime, Shale	3777	
Broken Lime	3850	SHT 3800 - OK
Lime	3875	
Shale, Lime	3881	
Shale	3885	
Lime	3895	
Broken Lime, Shale	3911	
Shale, Lime Shells	3933	
Shale	3945	
Lime	3949	
Shale	3985	
Broken Lime and Shale	3997	
Shale and Lime Shells	4017	
Lime	4022	
Broken Lime and Shale	4030	
Sandy Shale	4042	
Shale	4055	SHT 4050 - OK
Lime	4063	
Sandy Shale	4072	
Sand	4082	
Shale	4091	
Sandy Shale	4098	
Lime	4243	Show Oil 4237 - 4243
Cored Lime	4257	
Cored Lime	4258	
Lime	4395	SHT 4275 - OK
Oolitic Lime	4401	
Lime	4465	
Shale	4480	
Lime	4527	
Lime and Shale	4546	
Lime	4610	
Shale	4615	
Lime and Shale	4640	

**PLUGGING**  
 FILE SEC 6-32S-14W  
 BOOK PAGE 14 LINE 8

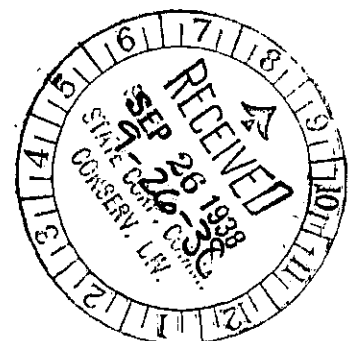

**FORMATION RECORD**

<u>FORMATION</u>	<u>FROM</u>	<u>REMARKS</u>
Lime	4647	
Cherty Lime and Shale	4655	
Lime	4695	
Shale	4707	
Lime	4709	
Cored Lime	4725	
Cored Lime	4730	
Cored Lime	4742	Oil and Gas Show
Cored Lime	4746 $\frac{1}{2}$	Oil and Gas Show
Lime	4843	
Shale	4845	
Cored Sand	4856	
Cored Sand	4864	
Shale	4867	
Shale and Broken Lime	4879	
Shale	4929	
Cored Shale	4940	
Cored Shale	4957	
Cored Lime	4970	
Lime	4980	Dry

**PLUGGING**  
 FILE SEC-6-T32-R144  
 BOOK PAGE 14-LINE 8

