

STATE OF KANSAS
STATE CORPORATION COMMISSION


WELL PLUGGING RECORD

OR
FORMATION PLUGGING RECORD

Strike out upper line
when reporting plug-
ging of formations.

Give All Information Completely
Make Required Affidavit
Mail or Deliver Report to:
Conservation Division
State Corporation Commission
800 Biting Building
Wichita, Kansas

NORTH

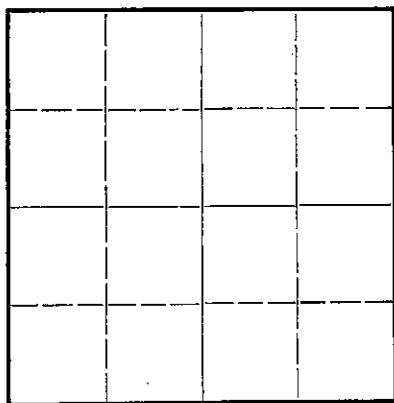

Locate well correctly on above
Section Flat

Barber County. Sec. 5 Twp. 32 Rge. 14 (E) 14 (W)
Location as "NE¼NW¼SW¼" or footage from lines 660' from West line
330' from south line SW¼
Lease Owner National Associated Petroleum Co.
Lease Name Susie Smith Well No. 1
Office Address 116 W. 24th St., Hutchinson, Kansas
Character of Well (completed as Oil, Gas or Dry Hole) Rotary dry hole
Date well completed 1/8/50 19
Application for plugging filed 1/8/50 19
Application for plugging approved 1/8/50 19
Plugging commenced 1/8/50 19
Plugging completed 1/8/50 19
Reason for abandonment of well or producing formation Dry hole

If a producing well is abandoned, date of last production X 19
Was permission obtained from the Conservation Division or its agents before plugging was com-
menced? Yes

Name of Conservation Agent who supervised plugging of this well C. D. Stough
Producing formation None Depth to top X Bottom X Total Depth of Well 4915½ Feet
Show depth and thickness of all water, oil and gas formations.

OIL, GAS OR WATER RECORDS

CASING RECORD

Formation	Content	From	To	Size	Put In	Pulled Out
Surface sands & soils	dry	0	40	10 3/4"	715 feet	None
Clay and shale		40	440			
Clay and sandy shale		440	940			

Describe in detail the manner in which the well was plugged, indicating where the mud fluid was placed and the method or methods used in introducing it into the hold. If cement or other plugs were used, state the character of same and depth placed, from _____ feet to _____ feet for each plug set.

Filled hole with heavy rotary mud from T.D. (4915½) to within 200 feet of top hole where wooden plug was set and 15 sacks cement was dumped on top plug. Hole was mudded with heavy rotary mud from top cement to within 20 feet of top where another wooden plug was set and 10 sacks cement was dumped on top of plug filling surface casing and bottom cellar.

Surface pipe was cemented at time it was run and cement circulated

JAN 17 1950
STATE OF KANSAS
CORPORATION COMMISSION
WICHITA

(If additional description is necessary, use BACK of this sheet)

Correspondence regarding this well should be addressed to Harbar Drilling Co.
Address 1019 Central Bldg., Wichita, Kansas

STATE OF Kansas, COUNTY OF Barber Sedgwick, ss.
K. Don S. Packer (employee of owner) or (owner or operator) of the above-described well,
being first duly sworn on oath, says: That I have knowledge of the facts, statements and matters herein contained and the log of the above-described well as filed and that the same are true and correct. So help me God.

(Signature)

(Address)

SUBSCRIBED AND SWORN to before me this 16 day of January, 1950

John Kelly
Notary Public.

My commission expires March 22, 1952

20-1300-s 11-43-10M
PLUGGING
FILE SEC 5 T 32 R 14
BOOK PAGE 133 LINE 9

SUSIE SMITH NO. 1

Center S $\frac{1}{2}$ SW $\frac{1}{4}$ NW $\frac{1}{4}$ Sec. 5-32-14W, Barber County, Kansas

Rigging up Rotary Tools 12-6-49
Tearing down Rotary Tools 1-9-50

Ran 18 Jts. 10 3/4" surface pipe. Set at 715' and cemented with 450 sz cement

<u>FORMATION</u>	<u>FROM</u>	<u>TO</u>
Sand and clay	0	40
Clay and shale	40	440
Shale and sand shells	440	940
Shale and shells	940	1650
Shale and lime	1650	2125
Lime	2125	2165
Lime and shale	2165	2235
Lime	2235	2290
Lime and shale	2290	2435
Lime	2435	2620
Lime and shale	2620	4045
Lime	4045	4555
Lime and shale	4555	4577
Lime	4577	4605
Shale and lime	4605	4645
Lime	4645	4657
Lime and Chert	4657	4663
Lime	4663	4668
Lime and shale	4668	4693
Lime	4693	4724
Lime and shale	4724	4743
Lime	4743	4745
Cherty Lime	4745	4765
Lime	4765	4788
Lime, shale and sand	4788	4798
Lime and sand	4798	4812
Lime	4812	4825
Sand and shale	4825	4840
Sand, shale and lime	4840	4878
Lime	4878	4915

Total depth 1950

JAN 1 1950
1-17 50

I, Don S. Packer, hereby certify that the above log is true and correct to the best of my knowledge and belief.

Don S. Packer

Subscribed and sworn to before me this 16th day of January, 1950.

Nelson Kelly
Notary Public

My commission expires: March 22, 1952

