


STATE OF KANSAS
STATE CORPORATION COMMISSION

WELL PLUGGING RECORD

Give All Information Completely
Make Required Affidavit
Mail or Deliver Report to
Conservation Division
State Corporation Comm.
245 North Water
Wichita, KS 67202

Barber County, Sec. 1 Twp. 32S Rge. 14W ~~xxx~~
Location as "NE/CNW $\frac{1}{4}$ SW $\frac{1}{4}$ " or footage from lines
C SW NW

Lease Owner D. R. Lauck Oil Company, Inc.
Lease Name Lake Estate Well No. 1
Office Address 221 S. Broadway, Wichita, Kansas
Character of Well (Completed as Oil, Gas or Dry Hole) Dry Hole

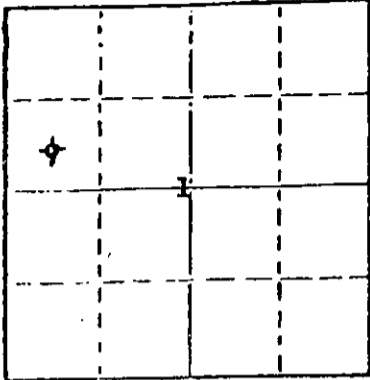

Locate well correctly on above
Section Plat

Date Well completed September 15, 1978
Application for plugging filed September 15, 1978
Application for plugging approved September 15, 1978
Plugging commenced September 15, 1978
Plugging completed September 15, 1978
Reason for abandonment of well or producing formation Dry Hole

If a producing well is abandoned, date of last production
19

Was permission obtained from the Conservation Division or
its agents before plugging was commenced? Yes

Name of Conservation Agent who supervised plugging of this well William T. Owen
Producing formation Depth to top Bottom Total Depth of Well 4660'
Show depth and thickness of all water, oil and gas formations.

OIL, GAS OR WATER RECORDS

CASING RECORD

FORMATION	CONTENT	FROM	TO	SIZE	PUT IN	PULLED OUT
		0'	310'	8.5/8"	303.88'	None

Describe in detail the manner in which the well was plugged, indicating where the mud fluid
was placed and the method or methods used in introducing it into the hold. If cement or other
plugs were used, state the character of same and depth placed, from feet to
 feet for each plug set.

Plugged with 35 sacks cement and plug at 300',
12 sacks cement and plug at 40', and 3 sacks
cement in rat hole.

RECEIVED
STATE CORPORATION COMMISSION
9-21-78
SEP 21 1978

(If additional description is necessary, use BACK of this sheet)

Name of Plugging Contractor Allied Cementing Co. CONSERVATION DIVISION
Wichita, Kansas

STATE OF KANSAS COUNTY OF SEDGWICK, ss.
John D. Knightley (employee of owner) or (owner or operator)

of the above-described well, being first duly sworn on oath, says: That I have knowledge of
the facts, statements, and matters herein contained and the log of the above-described well
as filed and that the same are true and correct. So help me God.

(Signature) *John D. Knightley*
221 S. Broadway, Wichita, Kansas
(Address)

SUBSCRIBED AND SWORN TO before me this 20th day of September, 1978

Stella J. Lipp
Notary Public.

My commission expires March 12, 1979

D. R. Lauck Oil Company, Inc. - Lake Estate #1
C SW NW Sec. 1-32S-14W
Barber County, Kansas

Contractor: D. R. Lauck Oil Company, Inc.
221 S. Broadway, Suite 400
Wichita, Kansas 67202

Commenced: September 5, 1978
Completed: September 15, 1978

Drillers Log

Red Bed & Gyp	904
Shale & Lime	1890
Lime & Shale	3447
Lime	4660 RTD

RECEIVED
STATE CORPORATION COMMISSION

SEP 21 1978
7-21-78
CONSERVATION DIVISION
Wichita, Kansas