


STATE OF KANSAS
STATE CORPORATION COMMISSION

Form CP-4

WELL PLUGGING RECORD

Give All Information Completely
Make Required Affidavit
Mail or Deliver Report to:
Conservation Division
State Corporation Commission
P. O. Box 17027
Wichita, Kansas 67217

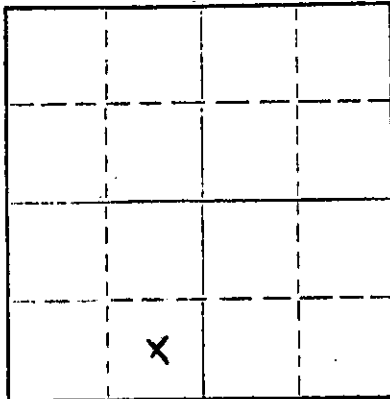

Locate well correctly on above
Section Plat

Barber County, Sec. 1 Twp. 32 Rge. 14 (E) W (W)
Location as "NE/CNW/SW" or footage from lines C SE SW SW
Lease Owner Bowers Drlg. Co., Inc.
Lease Name Lake 'A' Well No. # 2
Office Address 1434 Wichita Plaza ; Wichita, Ks. 67202
Character of Well (completed as Oil, Gas or Dry Hole) _____
Date well completed _____ 19____
Application for plugging filed _____ December 1971
Application for plugging approved _____ December 1971
Plugging commenced _____ January 21 1972
Plugging completed _____ January 31 1972
Reason for abandonment of well or producing formation _____

If a producing well is abandoned, date of last production _____ 19____
Was permission obtained from the Conservation Division or its agents before plugging was commenced? Yes

Name of Conservation Agent who supervised plugging of this well Russell Biberstein
Producing formation _____ Depth to top _____ Bottom _____ Total Depth of Well _____ Feet
Show depth and thickness of all water, oil and gas formations.

OIL, GAS OR WATER RECORDS

CASING RECORD

FORMATION	CONTENT	FROM	TO	SIZE	PUT IN	PULLED OUT
				8 5/8"	254	None
				4 1/2"	3820	3132

Describe in detail the manner in which the well was plugged, indicating where the mud fluid was placed and the method or methods used in introducing it into the hole. If cement or other plugs were used, state the character of same and depth placed, from _____ feet to _____ feet for each plug set.

January 21, 1972 Plugged off bottom. Dumped sand to 3475'. Mixed and dumped 4 sx of cement.
January 31, 1972 Plugged off top. Set 10' rock bridge at 240'. Filled 8 5/8" surface casing from 240' to base of cellar with 3000 lb. P.S.I. ready-mix concrete.


RECEIVED
STATE CORPORATION COMMISSION
3-6-72
MAR 6 1972
CONSERVATION DIVISION
Wichita, Kansas

(If additional description is necessary, use BACK of this sheet)
Name of Plugging Contractor RUSS CASING PULLING, INC.
Address P. O. BOX 1082 ; GREAT BEND, KANSAS 67530

STATE OF KANSAS COUNTY OF SEDGWICK, ss.
Emil E. Bowers (employee of owner) or (owner or operator) of the above-described well, being first duly sworn on oath, says: That I have knowledge of the facts, statements, and matters herein contained and the log of the above-described well as filed and that the same are true and correct. So help me God.

(Signature) Emil E. Bowers
Suite 1425, 125 North Market, Wichita, Kansas
(Address)

Subscribed and sworn to before me this 3rd day of March, 1972
My commission expires May 12, 1973
Charles A. Young Notary Public.

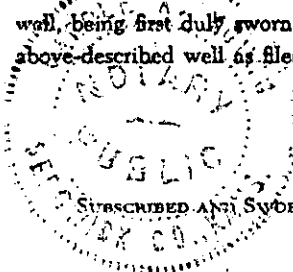

WELL LOG

COMPANY: Bowers Drilling Company, Inc.
CONTRACTOR: Bowers Drilling Company, Inc.
WELL: Lake "A" #2
LOCATION: C SE SW SW Section 1-328-14N
 Barber County, Kansas
COMPLETED: 2-12-68
OPERATED: 2-19-68
ELEVATION: 1655 E. S.

0 - 1000	Red Bed	Set 8-5/8" casing at 254' with 200 sacks
1000 - 1760	Shale	
1760 - 1936	Lime and Shale	
1936 - 2653	Lime	
2653 - 3828	Lime and shale	
3828	T. D.	Set 4 1/2" casing at 3824' w/500 gal. mud flush and 150 sacks cement

LOG TOPS:

Howard	3190 (-1535)	
Elain Scan	3401 (-1746)	
Lecompton	3465 (-1810)	
Hochmer	3684 (-2029)	
Toronto	3698 (-2043)	
Douglas Shale	3714 (-2059)	
Douglas Sand	3800 (-2153)	
Douglas Sand (porosity)	3826 (-2171) (estimated)	
Log T. D.	3817 - could not reach bottom due to cavings	

RECEIVED
 STATE CORPORATION COMMISSION
 1-12-72
 JAN 12 1972
 CONSERVATION DIVISION
 Wichita, Kansas

STATE OF KANSAS)
) SS
 COUNTY OF SHUTWICK)

I, Emil E. Bowers, do hereby certify that the above and foregoing is a true and correct copy of the log of the Lake "A" #2 located C SE SW SW Section 1-328-14N, Barber County, Kansas, as reflected by the files of Bowers Drilling Company, Inc.


 Emil E. Bowers, President.

Subscribed and sworn to before me, a Notary Public, in and for the State of Kansas this 26th day of February, 1968.


 Sherry Gish, Notary Public

My commission expires 6-31-71