


WELL PLUGGING RECORD

Give All Information Completely  
Make Required Affidavit  
Mail or Deliver Report to:  
Conservation Division  
State Corporation Commission  
212 No. Market  
Wichita, Kansas

Barber County, Sec. 1 Twp. 32S Rge. 14 (E) W. (W)

Location as "NE/CNW/SW" or footage from lines C SW SE  
Lease Owner Bowers Drilling Company  
Lease Name Lake Well No. C #1  
Office Address 1434 Wichita Plaza Wichita, Kansas  
Character of Well (completed as Oil, Gas or Dry Hole) Gas  
Date well completed 4-8 19 68  
Application for plugging filed August 19 69  
Application for plugging approved August 19 69  
Plugging commenced October 17 19 69  
Plugging completed October 21 19 69  
Reason for abandonment of well or producing formation No longer producing

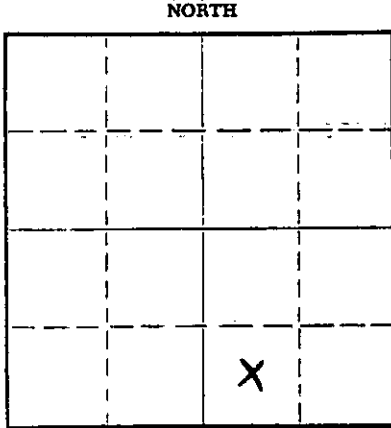

Locate well correctly on above Section Plat

If a producing well is abandoned, date of last production August 19 69  
Was permission obtained from the Conservation Division or its agents before plugging was commenced? Yes

Name of Conservation Agent who supervised plugging of this well Ralph Warren  
Producing formation LeCompton Depth to top Bottom Total Depth of Well 4423 Feet  
Show depth and thickness of all water, oil and gas formations.

OIL, GAS OR WATER RECORDS

CASING RECORD

FORMATION	CONTENT	FROM	TO	SIZE	PUT IN	PULLED OUT
				8 5/8	294	None
				4 1/2	3911	2983

Describe in detail the manner in which the well was plugged, indicating where the mud fluid was placed and the method or methods used in introducing it into the hole. If cement or other plugs were used, state the character of same and depth placed, from feet to feet for each plug set.

October 17, 1969 Dumped sand to 3200'. Mixed and dumped 4 sx of cement to 3150'

October 21, 1969 Set 10' rock bridge from 265' to 255'. Mixed and dumped 25 sx of cement. Mudded 8 5/8 casing to 40'. Set 10' rock bridge from 40' to 30'. Mixed and dumped 10 sx of cement from 30' to base of cellar.

RECEIVED  
STATE CORPORATION COMMISSION  
NOV 12 1969  
CONSERVATION DIVISION  
Wichita, Kansas

(If additional description is necessary, use BACK of this sheet)  
Name of Plugging Contractor RUSS CASING PULLING, INC.  
Address P. O. Box 1082 Great Bend, Kansas 67530

STATE OF KANSAS, COUNTY OF SEDGWICK, ss.  
Emil E. Bowers (employee of owner) or (owner or operator) of the above-described well, being first duly sworn on oath, says: That I have knowledge of the facts, statements, and matters herein contained and the log of the above-described well as filed and that the same are true and correct. So help me God.

(Signature) Emil E. Bowers  
1434 Wichita Plaza Bldg.  
(Address)

SUBSCRIBED AND SWORN TO before me this 10th day of November, 19 69

Carole A. Young  
Notary Public.

My commission expires May 12, 1973

