


STATE OF KANSAS
STATE CORPORATION COMMISSION

15-007-00144-00-00
WELL PLUGGING RECORD

Give All Information Completely
Make Required Affidavit
Mail or Deliver Report to:
Conservation Division
State Corporation Commission
800 Biting Building
Wichita, Kansas

NORTH

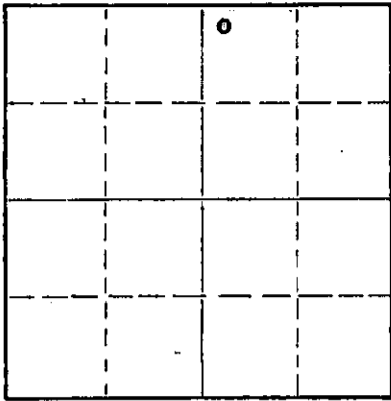

Locate well correctly on above
Section Plat

Barber County, Sec. 6 Twp. 32S Rge. (E) 10 (W)

Location as "NE/CNWxSWx" or footage from lines NW NW NE
Lease Owner Grahamart-Miller Oil Company
Lease Name Dick "A" Well No. 1
Office Address 1005 East Second, Wichita, Kansas
Character of Well (completed as Oil, Gas or Dry Hole) _____
Date well completed February 19, 1955 19
Application for plugging filed February 22, 1955 19
Application for plugging approved February 23, 1955 19
Plugging commenced March 10, 1955 19
Plugging completed March 13, 1955 19
Reason for abandonment of well or producing formation Dry Hole

If a producing well is abandoned, date of last production -- 19
Was permission obtained from the Conservation Division or its agents before plugging was commenced? Yes

Name of Conservation Agent who supervised plugging of this well Mr. M. A. Rives, Box 8, Pratt, Kansas
Producing formation _____ Depth to top _____ Bottom _____ Total Depth of Well 4932 Feet
Show depth and thickness of all water, oil and gas formations.

OIL, GAS OR WATER RECORDS

CASING RECORD

FORMATION	CONTENT	FROM	TO	SIZE	PUT IN	PULLED OUT
				8 5/8"	233'	None
				5 1/2"	4490	3462

Describe in detail the manner in which the well was plugged, indicating where the mud fluid was placed and the method or methods used in introducing it into the hole. If cement or other plugs were used, state the character of same and depth placed, from _____ feet to _____ feet for each plug set.

Plugged back with crushed rock to 4420'. Dumped 5 sacks cement at 4420'; top of cement 4385'. Filled with mud to 230' and set rock bridge. Dumped 20 sacks cement; top of cement 170'. Filled with mud to 35'. Set rock bridge and dumped 10 sacks cement.

STATE CORPORATION COMMISSION
Wichita, Kansas
03-17-1955

(If additional description is necessary, use BACK of this sheet)
Name of Plugging Contractor Miller Casing Pulling Company (License No. 12) 1955
Address Great Bend, Kansas

STATE OF Kansas, COUNTY OF Sedgwick, ss.
J. A. Gilliland (employee of owner) or ~~owner or operator~~ of the above-described well, being first duly sworn on oath, says: That I have knowledge of the facts, statements, and matters herein contained and the log of the above-described well as filed and that the same are true and correct. So help me God.

(Signature) J. A. Gilliland
1005 East Second, Wichita, Kansas
(Address)

SUBSCRIBED AND SWORN TO before me this 16th day of March, 19 55
Juanita L. Davis
Notary Public.

My commission expires November 5, 1958

PLUGGING
FILE SEC 6-1-32 P. 1061
BOOK PAGE 98 LINE 37

15-007-00144-00-00

NO. 1 DEEP WELL

WELL RECORD

Location: NW 1/4 Sec. 6-120-105
Harber County, Kansas

Commenced: January 16, 1955

Operator: Branchart-Killar Oil Company
1005 East Second, Wichita, Kansas

Completed: February 6, 1955

Elevation: 1628 KB

Contractor: Graham-Messner-Branchart Drilling Co.
1005 East Second, Wichita, Kansas

Production:

Casing Record: 8 5/8" @ 233' w/135 sacks cement
5 1/2" @ 1490' w/75 sacks cement

....L O S....

Red Sed	224
Red Sed-Shale	233
Shale	2870
Lim-Shale	3030
Lim-Shale-Sand	3705
Sandy Lim-Shale	3785
Lim-Shale	3853
Lim	4244
Lim-Shale	4445
Lim-Chert	4487
Lim-Chert-Shale	4511
Lim	4542
Lim-Shale-Chert	4604
Lim	4648
Lim-Shale	4735
Lim	4749
Sand-Lime	4812
Sand	4827
Coring (Sand)	4852
Shale	4878
Carl-Arbuckle	4932 R.V.D.

Log Tops:

Sample Tops:

Nebehor 3601 (-1973)	
Douglas 3627 (-1959)	
Landing 3785 (-2157)	3785 (-2150)
Mississippi 4439 (-2802)	4431 (-2803)
Hindorhook Sh 4615 (-3087)	4615 (-2987)
Chattanooga Sh 4642 (-3034)	4643 (-3035)
Viola 4715 (-3087)	4717 (-3009)
Clipsen Sh 4777 (-3149)	4777 (-3149)
Clipsen SA 4779 (-3151)	4778 (-3150)
Arbuckle 4904 (-3276)	4904 (-3276)

The undersigned, GRAHAM-MESSNER-BRANCHART DRILLING COMPANY, hereby certifies that the above log is a true and correct log of the formation encountered in drilling the above well as reflected by the Daily Drilling Report.

GRAHAM-MESSNER-BRANCHART DRILLING COMPANY

By: J. E. Gilliland
J. E. Gilliland

Subscribed and sworn to before me this 15th day of February 1955.

Quanta L. Louis
Notary Public

My Commission Expires: November 5, 1958

PLUGGING	
WELL REC	T—R—
BOOK PAGE	LINE

STATE OF KANSAS
CONSERVATION DIVISION
Wichita, Kansas

03-17-1955