


OR  
FORMATION PLUGGING RECORD

Strike out upper line  
when reporting plug-  
ging off formations.

Give All Information Completely  
Make Required Affidavit  
Mail or Deliver Report to:  
Conservation Division  
State Corporation Commission  
800 Blitting Building  
Wichita, Kansas

Barber County, Sec. 5 Twp. 32S. Rge. (E) 10 (W)  
Location as "NE $\frac{1}{4}$ NW $\frac{1}{4}$ SW $\frac{1}{4}$ " or footage from lines. SW/4 NW/4 SW/4  
Lease Owner Continental Oil Company  
Lease Name B. E. Thompson Well No. 1  
Office Address Drawer 1267, Ponca City, Oklahoma  
Character of Well (completed as Oil, Gas or Dry Hole) Dry Hole  
Date well completed June, 19 1950  
Application for plugging filed August 16, 1950  
Application for plugging approved August 18, 1950  
Plugging commenced September 20, 1950  
Plugging completed September 23, 1950  
Reason for abandonment of well or producing formation  
If a producing well is abandoned, date of last production 19  
Was permission obtained from the Conservation Division or its agents before plugging was com-  
menced? Yes

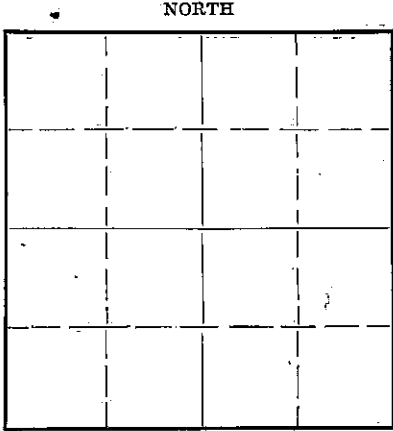

Locate well correctly on above  
Section Plat

Name of Conservation Agent who supervised plugging of this well Mr. C. D. Stough, Great Bend, Kansas  
Producing formation Mississippi Depth to top 4438' Bottom 4795' Total Depth of Well 4985' Feet  
Show depth and thickness of all water, oil and gas formations.

OIL, GAS OR WATER RECORDS

CASING RECORD

Formation	Content	From	To	Size	Put In	Pulled Out
Mississippi	Dry	4438'	4795'	10 3/4 7	202' 1" 4591'	None 2871' 7"

Describe in detail the manner in which the well was plugged, indicating where the mud fluid was placed and the method or methods used in introducing it into the hole. If cement or other plugs were used, state the character of same and depth placed, from \_\_\_\_\_ feet to \_\_\_\_\_ feet for each plug set.

Dumped 2000 pounds crushed rock and 9 sacks cement to 4438'; ripped and pulled approximately 2872' of 7" casing; filled hole with heavy mud to 210'; set plug at 210' and cemented with 20 sacks; filled hole with heavy mud to 30' and capped with 10 sacks cement. Plugged and abandoned 9-23-50.

RECEIVED  
STATE CORPORATION COMMISSION  
OCT 16 1950  
CONSERVATION DIVISION  
Wichita, Kansas

10-16-1950

(If additional description is necessary, use BACK of this sheet)  
Correspondence regarding this well should be addressed to F. L. Dunn  
Address R. F. D. #4 Lyons, Kansas

STATE OF KANSAS COUNTY OF RICE, ss.  
F. L. Dunn (employee of owner) or (owner or operator) of the above-described well,

being first duly sworn on oath, says: That I have knowledge of the facts, statements, and matters herein contained and the log of the above-described well as filed and that the same are true and correct. So help me God.

FLD-AEA  
State Corp. Comm.  
ECW  
File

(Signature)

*F. L. Dunn*

R. F. D. #4, Lyons, Kansas  
(Address)

SUBSCRIBED AND SWORN to before me this 12th day of October, 1950.

*J. E. Fitzgerald*

Notary Public.

My commission expires December 31, 1953

PLUGGING  
FILE SEC 5 T 32 R 10 W  
BOOK PAGE 22 LINE 7