


15-007-00602-00-00

WELL PLUGGING RECORD

Give All Information Completely  
Make Required Affidavit  
Mail or Deliver Report to:  
Conservation Division  
State Corporation Commission  
211 No. Broadway  
Wichita, Kansas

Barber County. Sec. 4 Twp. 32S Rge. (E) 10 (W)  
Location as "NE/CNWxSWx" or footage from lines C-NW NE  
Lease Owner Pickrell Drilling Company  
Lease Name Schreiner Well No. 1  
Office Address 705 Fourth Nat'l. Bank Bldg, Wichita 2, Kansas  
Character of Well (completed as Oil, Gas or Dry Hole) Dry Hole  
Date well completed 11-16 19 58  
Application for plugging filed 11-16 19 58  
Application for plugging approved 11-16 19 58  
Plugging commenced 11-16 19 58  
Plugging completed 11-16 19 58  
Reason for abandonment of well or producing formation Dry & Abandoned

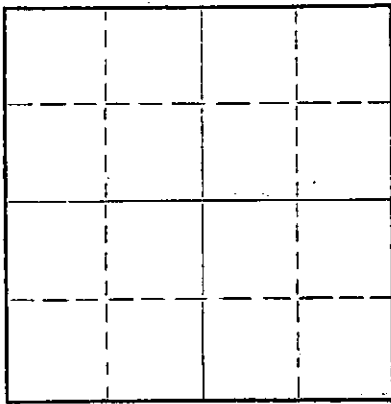

Locate well correctly on above Section Plat

If a producing well is abandoned, date of last production 19  
Was permission obtained from the Conservation Division or its agents before plugging was commenced? Yes

Name of Conservation Agent who supervised plugging of this well  
Producing formation Depth to top Bottom Total Depth of Well 4545 Feet  
Show depth and thickness of all water, oil and gas formations.

OIL, GAS OR WATER RECORDS

CASING RECORD

FORMATION	CONTENT	FROM	TO	SIZE	PUT IN	PULLED OUT
				8 5/8"	200'	None

Describe in detail the manner in which the well was plugged, indicating where the mud fluid was placed and the method or methods used in introducing it into the hole. If cement or other plugs were used, state the character of same and depth placed, from feet to feet for each plug set.

Filled with heavy mud to 190', bridge hole and cement with 20 sacks cement.  
Then heavy mud to 35' below ground level, bridge hole and cement with 10 sacks cement to bottom of cellar.

(If additional description is necessary, use BACK of this sheet)

Name of Plugging Contractor Pickrell Drilling Company  
Address 705 Fourth Nat'l. Bank Bldg., Wichita 2, Kansas

STATE OF KANSAS, COUNTY OF SEDGWICK, ss.  
C. W. SEBITS (employee of owner) or (owner or operator) of the above-described

well, being first duly sworn on oath, says: That I have knowledge of the facts, statements, and matters herein contained and the log of the above-described well as filed and that the same are true and correct. So help me God.

(Signature) *C. W. Sebits*  
705 Fourth Nat'l. Bank Bldg, Wichita, Kansas (Address)

SUBSCRIBED AND SWORN TO before me this 26th day of November, 1958

*Martha Scott*  
(Martha Scott) Notary Public.

My commission expires Dec. 6, 1958

PLUGGING  
FILE SEC 4 T 32 R 10W  
BOOK PAGE 140 LINE 16

RECEIVED  
STATE CORPORATION COMMISSION  
11-26-1958  
NOV 26 1958  
CONSERVATION DIVISION  
Wichita, Kansas

ROTARY DRILLING LOG

15-007-00602-00

COMPANY: Pickrell Drilling Company

Rotary Drilling Commenced 11-3-58

Rotary Drilling Completed 11-16-58

LOCATION: C-NW NE Sec. 4-32S-10W  
Barber County, Kansas  
Schreiner #1

CONTRACTOR: **PICKRELL DRILLING COMPANY**  
Wichita, Kansas

CASING RECORD: Set 200' of 8-5/8" OD surface casing at 203' with 100 sacks common  
2% Gel. Cement circulated.

LOG

(Figures indicate bottom of formation — measurements from top of rotary bushing.)

Shale & Rock	20'	Circ. for Samples at	4450'
Sand & Gravel	42'		4485'
Red Rock	203'		4545'
Shale	970'		
Shale & Lime	1780'		
Lime	1935'		
Lime & Shale	2045'		
Lime	2140'		
Lime & Shale	3050'		
Lime	3225'		
Lime & Shale	3440'		
Lime, Sand & Shale	3580'		
Lime & Shale	3652'		
(Heebner)	3623'		
Lime & Shale	3750'		
Lime	3830'		
Lime & Shale	3873'		
Lime	4251'		
Lime & Shale	4444'		
Mississippi	4545' T.D.		

S.L.M. at 2000 - O.K.  
3000 - O.K.  
4000 - O.K.

Slope Test at 2000 0° off  
2500 0° off  
3000 0° off  
3500 0° off  
4000 0° off

**RECEIVED**  
STATE CORPORATION COMMISSION

NOV 26 1958

CONSERVATION DIVISION  
Wichita, Kansas

11-26-1958

**PLUGGING**  
FILE SEC 4 T32 R10W  
BOOK PAGE 48 LINE 16

The undersigned, C. W. Sebitts, Attorney-in-Fact for PICKRELL DRILLING COMPANY, hereby certifies in behalf of said Company, that the above is a true and correct log of the formation encountered in drilling the above well as reflected by the Daily Drilling Reports.

PICKRELL DRILLING COMPANY  
By [Signature]  
Attorney-in-Fact

STATE OF KANSAS }  
COUNTY OF SEDGWICK } ss.

On this 25th day of November, 1958, before me the undersigned, a Notary Public, in and for

the County and State aforesaid, personally appeared C. W. Sebitts, to me known to be the identical person who subscribed the name of PICKRELL DRILLING COMPANY to the foregoing instrument as its Attorney-in-Fact and acknowledged to me that he executed the same as his free and voluntary act and deed, and as the free and voluntary act and deed of such company, for the uses and purposes therein set forth.

Given under my hand and seal of office the day and year last above written.

My commission expires: Dec. 6, 1958

[Signature]  
Notary Public  
(Martha Scott)