

WELL PLUGGING RECORD


Give All Information Completely
Make Required Affidavit
Mail or Deliver Report to:
Conservation Division
State Corporation Commission
211 No. Broadway
Wichita, Kansas

Barber

County. Sec. 3 Twp. 32 Rge. 10W (E) (W)

Location as "NE/CNW/SW" or footage from lines CNW/4 SW/4
Lease Owner Sinclair Oil & Gas Company
Lease Name Max Rowe Unit Well No. 1
Office Address P. O. Box 521, Tulsa, Oklahoma
Character of Well (completed as Oil, Gas or Dry Hole) Dry Hole
Date well completed August 4th 19 58
Application for plugging filed August 4th 19 58
Application for plugging approved August 5th 19 58
Plugging commenced August 4th 19 58
Plugging completed August 4th 19 58
Reason for abandonment of well or producing formation Dry Hole

NORTH

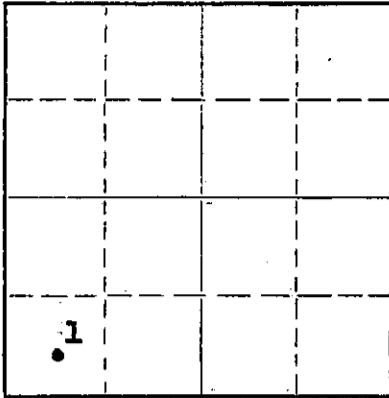

Locate well correctly on above Section Plat

If a producing well is abandoned, date of last production _____ 19 ____
Was permission obtained from the Conservation Division or its agents before plugging was commenced? Yes

Name of Conservation Agent who supervised plugging of this well W. L. Lackamp
Producing formation None Depth to top _____ Bottom _____ Total Depth of Well _____ Feet
Show depth and thickness of all water, oil and gas formations.

OIL, GAS OR WATER RECORDS

CASING RECORD

FORMATION	CONTENT	FROM	TO	SIZE	PUT IN	PULLED OUT
No producing formations encountered				10-3/4"	274'	None

Describe in detail the manner in which the well was plugged, indicating where the mud fluid was placed and the method or methods used in introducing it into the hole. If cement or other plugs were used, state the character of same and depth placed, from _____ feet to _____ feet for each plug set.

Well drilled to a Total depth of 4595'. Plugged from 4595' to 260' with heavy drilling mud, from 260' to 210' with 25 sacks cement, from 210' to 30' with heavy drilling mud, from 30' to surface with 15 sacks cement.

(If additional description is necessary, use BACK of this sheet)

Name of Plugging Contractor Prime Drilling Company, 814-16 Union Center, Wichita, Kansas
Address _____

STATE OF Kansas COUNTY OF Rice, ss.

_____ (employee of owner) or (owner or operator) of the above-described well, being first duly sworn on oath, says: That I have knowledge of the facts, statements, and matters herein contained and the log of the above-described well as filed and that the same are true and correct. So help me God.

(Signature) W. B. Rhee
W. B. Rhee, Dist. Supt.
Box 551, Chase, Kansas
(Address)

SUBSCRIBED AND SWORN TO before me this 11th day of August, 19 58

My commission expires 10-21-59

William C. Hoo
Notary Public.

PLUGGING
FILE SEC. 3 T. 32 R. 10W
BOOK PAGE 120 LINE 51

RECEIVED
AUG 13 1958
08-13-1958
CONSERVATION DIVISION
Wichita, Kansas

15-007 - 01588-00-00

ROTARY DRILLING LOG

OPERATOR: Sinclair Oil and Gas Company
Max Rowe Unit #1
C NE SW Sec. 3-32-10W
Barber County, Kansas

CONTRACTOR: Prime Drilling Company
COMM: 7-19-58
COMP: 8-4-58

Formations:

Sand	40'
Red Bed	160'
Red Bed & Shale	274'
Red Bed	500'
Red Bed & Shale	770'
Shale & Shells	1100'
Lime	1655'
Lime & Shale	2145'
Shale & Lime	2690'
Lime & Shale	3125'
Shale & Lime	3260'
Lime & Shale	3300'
Shale	3365'
Lime & Shale	3663'
Lime	4452'
Lime & Shale	4503'
Shale & Chert	4560'
Cherty Lime	4575'
Lime	4595'
Rotary Total Depth (D&A)	4595'

Remarks: Set 10-3/4" surface casing
at 274' cemented with 250 sacks
regular cement, 2% C.C.

We certify the above log is true and
correct to the best of our knowledge
and belief.

PRIME DRILLING COMPANY

R. R. McNicol
R. R. McNicol

RECEIVED
STATE CORPORATION COMMISSION

AUG 13 1958

CONSTRUCTION DIVISION

08-13-1958

PLUGGING
FILE SEC. 3 T 32 R 10W
BOOK PAGE 120 LINE 31