


Give All Information Completely
Make Required Affidavit
Mail or Deliver Report to:
Conservation Division
State Corporation Commission
800 Biting Building
Wichita, Kansas

15-677-000 69-00-00
WELL PLUGGING RECORD

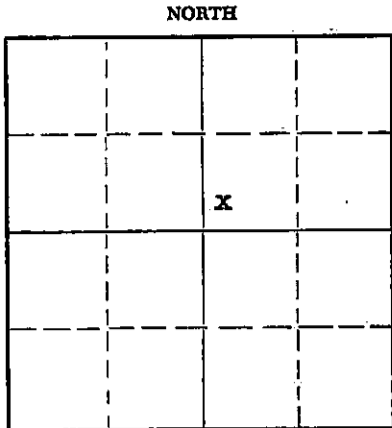

Locate well correctly on above
Section Flat

Harper County, Sec. 27 Twp. 33 Rge. 5 (E) (W)
Location as "NE/CNW/SW" or footage from lines SW SW NE
Lease Owner Halmerich & Payne, Inc.
Lease Name R.W. Rump Well No. 1
Office Address First Nat'l. Bldg. Tulsa 3, Oklahoma
Character of Well (completed as Oil, Gas or Dry Hole) Dry Hole
Date well completed January 4, 1962
Application for plugging filed January 12, 1962
Application for plugging approved 19
Plugging commenced January 4, 1962
Plugging completed January 9, 1962
Reason for abandonment of well or producing formation Dry Hole

If a producing well is abandoned, date of last production 19
Was permission obtained from the Conservation Division or its agents before plugging was commenced? Yes

Name of Conservation Agent who supervised plugging of this well Fred Hampel
Producing formation _____ Depth to top _____ Bottom _____ Total Depth of Well 4907 Feet
Show depth and thickness of all water, oil and gas formations.

OIL, GAS OR WATER RECORDS

CASING RECORD

FORMATION	CONTENT	FROM	TO	SIZE	PUT IN	PULLED OUT
				8 5/8	251	None
				5 1/2	4906	4270

Describe in detail the manner in which the well was plugged, indicating where the mud fluid was placed and the method or methods used in introducing it into the hole. If cement or other plugs were used, state the character of same and depth placed, from _____ feet to _____ feet for each plug set.

From: 4906' to 4850' Sand
4850 to 4825' 5 sax cement plug.
4825 to 250' Heavy drlg. mud.
250' to 185' Plug & 20 sax cement.
185' to 35' Heavy drlg. mud.
35' to Surface Plug & 10 sax cement.

RECEIVED
STATE CORPORATION COMMISSION
JAN 17 1962
CONSERVATION DIVISION
Wichita, Kansas
01-17-1962

(If additional description is necessary, use BACK of this sheet)
Name of Plugging Contractor Clyde Burnsworth - B & G Well Service
Address P.O. Box 526 Winfield, Kansas

STATE OF Oklahoma COUNTY OF Tulsa, ss.
Charles E. Adkins (employee of owner) or ~~owner or operator~~ of the above-described well, being first duly sworn on oath, says: That I have knowledge of the facts, statements, and matters herein contained and the log of the above-described well as filed and that the same are true and correct. So help me God.

(Signature) Charles E. Adkins
First Nat'l. Bldg. Tulsa 3, Oklahoma
(Address)

SUBSCRIBED AND SWORN to before me this 12 day of January, 1962

[Signature]
Notary Public.

My commission expires 8-19-65

