


Give All Information Completely
Make Required Affidavit
Mail or Deliver Report to:
Conservation Division
State Corporation Commission
800 Bittling Building
Wichita, Kansas

WELL PLUGGING RECORD

Harper County, Sec. 29 Twp. 32S Rge. 6 (W)

Location as "NE/CNWxSWx" or footage from lines NW NW SW
Lease Owner Herndon Drilling Company
Lease Name R. H. Watt Well No. 1
Office Address Drawer 489, Tulsa, Oklahoma
Character of Well (completed as Oil, Gas or Dry Hole) Dry Hole
Date well completed 10/20/56 19
Application for plugging filed 10/20/56 19
Application for plugging approved 10/20/56 19
Plugging commenced 10/20/56 19
Plugging completed 10/20/56 19
Reason for abandonment of well or producing formation Dry Hole

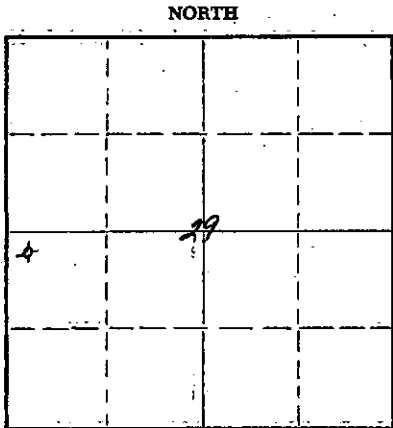

Locate well correctly on above Section Plat

If a producing well is abandoned, date of last production 19
Was permission obtained from the Conservation Division or its agents before plugging was commenced? Yes

Name of Conservation Agent who supervised plugging of this well M. A. Rives
Producing formation _____ Depth to top _____ Bottom _____ Total Depth of Well 4839 Feet
Show depth and thickness of all water, oil and gas formations.

OIL, GAS OR WATER RECORDS

CASING RECORD

FORMATION	CONTENT	FROM	TO	SIZE	PUT IN	PULLED OUT
				13-3/8"	158'	None

Describe in detail the manner in which the well was plugged, indicating where the mud fluid was placed and the method or methods used in introducing it into the hole. If cement or other plugs were used, state the character of same and depth placed, from _____ feet to _____ feet for each plug set.

Hole was filled with 11 lbs. mud to 155 ft. Hole bridged at 155 ft. Plug set on bridge and 35 sacks of cement on plug through drill pipe.

Hole filled with mud to 20 ft. Hole bridged at 20 ft. Plug on bridge and filled with cement to bottom of cellar.

RECEIVED
STATE CORPORATION COMMISSION
OCT 26 1956
CONSERVATION DIVISION
Wichita, Kansas
10-26-1956

(If additional description is necessary, use BACK of this sheet)
Name of Plugging Contractor Herndon Drilling Company
Address Drawer 489, Tulsa, Oklahoma

STATE OF OKLAHOMA COUNTY OF TULSA ss.
W. G. Prather (employee of owner) or (owner or operator) of the above-described well, being first duly sworn on oath, says: That I have knowledge of the facts, statements, and matters herein contained and the log of the above-described well as filed and that the same are true and correct. So help me God.

(Signature) W. G. Prather
Drawer 489, Tulsa, Oklahoma (Address)

SUBSCRIBED AND SWORN TO before me this 23rd day of October, 19 56
Ludwig Kiefer Notary Public.

My commission expires 1/27/60

PLUGGING
FILE SEC 29 T. 32 R. 6W
BOOK PAGE 110 LINE 16

15-077-00230-00-00

WELL LOG ON R. H. Watt #1

Spudding date: 10/2/56
Date casing set: 10/3/56
Date rotary completed: 10/20/56
Date cable completed:

Location:

NW NW SW, Section 29-32S-6W, Harper County, Kansas

FROM	TO	FORMATION	REMARKS
0	158	Surface Hole	Ran 4 Jts. 13-3/8" SW Casing, set @ 158' and cemented w/200 Sx. Cement and 2% C.C.
158	550	Red Bed	
550	1260	Shale & Shells	
1260	1335	Anhydrite	
1335	1785	Shale & Lime	
1785	1825	Lime	
1825	2855	Shale & Lime	
2855	3060	Lime	
3060	3103	Shale & Sand	
3103	3195	Sand	
3195	3210	Shale & Lime	
3210	3385	Lime	
3385	3480	Shale & Lime	
3480	3571	Lime	
3571	3661	Sand	
3661	3790	Lime & Shale	
3790	4084	Lime	
4084	4309	Lime & Shale	
4309	4343	Lime	
4343	4448	Lime & Shale	
4448	4730	Lime	
4730	4831	Lime & Shale	
4831	4839	Sand	
4839		Total Depth	

Plugging Record

Hole was filled with 11# mud to 155'. Hole bridged at 155'. Plug set on bridge and 35 Sx. cement on plug through drill pipe. Hole filled with mud to 20'. Hole bridged at 20'. Plug on bridge and filled w/cement to bottom of cellar.

10-26-1956

Subscribed and sworn to before me this 24th day of October, 19 56

I certify the above and foregoing to be a true and exact copy of the original driller's log on the R. H. Watt #1.

HERNDON DRILLING COMPANY

Audrey Dierker
Notary Public
My commission expires: 1/27/60

By: C. J. Moore
Title: Assistant Secretary

29.32 6W
110