

15:35-21446-0001


STATE OF KANSAS  
STATE CORPORATION COMMISSION

WELL PLUGGING RECORD

Give All Information Completely  
Make Required Affidavit  
Mail or Deliver Report to  
Conservation Division  
State Corporation Comm.  
245 North Water  
Wichita, KS 67202

Ness County. Sec. 28 Twp. 17 Rge. 23 E/W  
Location as "NE/CNW 1/4 SW 1/4" or footage from lines  
C NE NW

Lease Owner Montgomery Drilling Program  
Lease Name Anspaugh #1 Well No. \_\_\_\_\_  
Office Address San Francisco, California 94104  
Character of Well (Completed as Oil, Gas or Dry Hole) \_\_\_\_\_

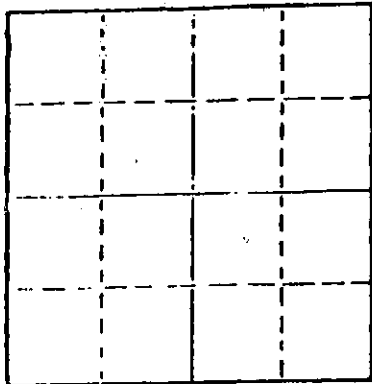

Locate well correctly on above Section Plat

Date Well completed \_\_\_\_\_ 19\_\_\_\_  
Application for plugging filed \_\_\_\_\_ 19\_\_\_\_  
Application for plugging approved \_\_\_\_\_ 19\_\_\_\_  
Plugging commenced 3/1/79 \_\_\_\_\_ 19\_\_\_\_  
Plugging completed 3/7/79 \_\_\_\_\_ 19\_\_\_\_  
Reason for abandonment of well or producing formation  
depleted.

If a producing well is abandoned, date of last production \_\_\_\_\_ 19\_\_\_\_

Was permission obtained from the Conservation Division or its agents before plugging was commenced? yes

Name of Conservation Agent who supervised plugging of this well Massey  
Producing formation \_\_\_\_\_ Depth to top \_\_\_\_\_ Bottom \_\_\_\_\_ Total Depth of Well 4470  
Show depth and thickness of all water, oil and gas formations.

OIL, GAS OR WATER RECORDS

CASING RECORD

FORMATION	CONTENT	FROM	TO	SIZE	PUT IN	PULLED OUT
				8-5/8	287	none
				4-1/2"	4460	3712'

Describe in detail the manner in which the well was plugged, indicating where the mud fluid was placed and the method or methods used in introducing it into the hold. If cement or other plugs were used, state the character of same and depth placed, from \_\_\_\_\_ feet to \_\_\_\_\_ feet for each plug set.

Pushed wood plug to 4300' and sanded to 4290', ran 3 sacks cement.  
Shot pipe at 3914', 3811', 3710', pulled 111 joints. Allied pumped  
20 sacks gel, 70 sacks cement, 8 sacks gel, plug and 1 sack hulls,  
70 sacks 50-50 pos, 2% gel.

PLUGGING COMPLETE.

RECEIVED  
STATE CORPORATION COMMISSION

(If additional description is necessary, use BACK of this sheet)

Name of Plugging Contractor KELSO CASING PULLING CHASE, KANSAS  
MAR 12 1979  
3-12-79  
CONSERVATION DIVISION  
Wichita, Kansas

STATE OF KANSAS COUNTY OF RICE, ss.  
R. DARRELL KELSO (employee of owner) or (owner or operator)  
of the above-described well, being first duly sworn on oath, says: That I have knowledge of the facts, statements, and matters herein contained and the log of the above-described well as filed and that the same are true and correct. So help me God.

(Signature) R. Darrell Kelso  
CHASE, KANSAS  
(Address)

SUBSCRIBED AND SWORN TO before me this 9th day of March, 19 79

Margaret Melcher  
Notary Public.

My commission expires \_\_\_\_\_

