


WELL PLUGGING RECORD

Give All Information Completely
Make Required Affidavit
Mail or Deliver Report to:
Conservation Division
State Corporation Commission
211 No. Broadway
Wichita, Kansas

NORTH

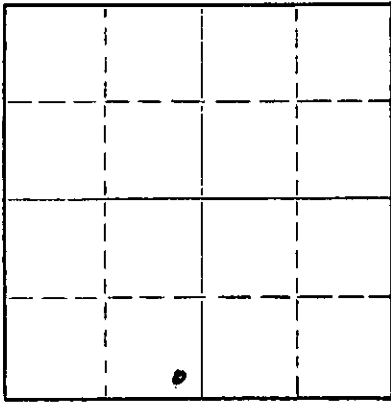

Locate well correctly on above
Section Plat

Ness County. Sec. 24 Twp. 17S Rge. (E) 23(W) 24
Location as "NE/CNW/SW" or footage from lines 297' WEL & 330' NSL of Sec. 24
Lease Owner Gulf Oil Corporation
Lease Name J. R. Elmore Well No. 1
Office Address Box 661, Tulsa, Oklahoma
Character of Well (completed as Oil, Gas or Dry Hole) Dry Hole
Date well completed 3-18-57
Application for plugging filed 3-18-57
Application for plugging approved 3-18-57
Plugging commenced 3-18-57
Plugging completed 3-19-57
Reason for abandonment of well or producing formation Dry Hole

If a producing well is abandoned, date of last production 19
Was permission obtained from the Conservation Division or its agents before plugging was commenced? Yes

Name of Conservation Agent who supervised plugging of this well R. M. Brundege
Producing formation _____ Depth to top _____ Bottom _____ Total Depth of Well 4895 Feet
Show depth and thickness of all water, oil and gas formations.

OIL, GAS OR WATER RECORDS

CASING RECORD

FORMATION	CONTENT	FROM	TO	SIZE	PUT IN	PULLED OUT
				8-5/8"	915'	- 0 -

Describe in detail the manner in which the well was plugged, indicating where the mud fluid was placed and the method or methods used in introducing it into the hole. If cement or other plugs were used, state the character of same and depth placed, from _____ feet to _____ feet for each plug set.

Filled with mud to 700'. Dumped one sack of hulls and placed HOWCO cementing plug. Run 35 sacks cement through drill pipe on plug. Filled with mud to 35'. Dumped 1/2 sack hulls and placed HOWCO plug. Capped with 12 sacks cement. Plugged rat hole with 3 sacks cement.

NOTE: Attached is Driller's Formation Record which is being filed in accordance with your instructions.

RECEIVED
STATE CORPORATION COMMISSION
4-2-57
APR 2 - 1957

CONSERVATION DIVISION
WICHITA, KANSAS

Name of Plugging Contractor Lewis Drilling Company
Address Union Center Building, Wichita, Kansas

STATE OF Kansas, COUNTY OF Sedgwick, ss.
Thomas A. Trax

(employee of owner) of the above-described well, being first duly sworn on oath, says: That I have knowledge of the facts, statements, and matters herein contained and the log of the above-described well as filed and that the same are true and correct. So help me God.

(Signature) Thomas A. Trax
Thomas A. Trax, Asst. Zone Supt. of Prod.
Box 2233, Wichita, Kansas
(Address)

SUBSCRIBED AND SWORN TO before me this 29th day of March, 19 57

Ray W. Row
Notary Public.

My commission expires 2-4-59

JRM:BJT
3-29-57

PLUGGING
FILE SEC 24 T. 17. R. 23W
BOOK PAGE 149. LINE 9

WELL LOG

15135-60160-0000

COMPANY Gulf Oil Corporation

SEC. 24 T. 17S R. 23W
LOC. SE 1/4 SW 1/4

FARM J. R. Elmore NO. 1

TOTAL DEPTH 4895'

COMM. 2-26-57


COMP. 3-19-57

SHOT OR TREATED

CONTRACTOR Lewis Drilling Company

ISSUED 3-28-57

COUNTY Ness
KANSAS

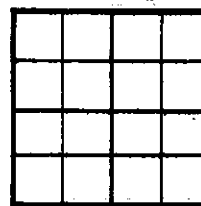

ELEVATION 2397 D.F.

PRODUCTION

Geologic Tops:

CASING

20 10
15 8 5/8"---914'
12 6
13 5

FIGURES INDICATE BOTTOM OF FORMATIONS

0 -60	Clay
60 -385	Shale & Sand Rock
385 -525	Shale & Lime Streaks
525 -667	Shale
667 -845	Shale & Shells
845 -1180	Red Bed
1180-1400	Sand
1400-1685	Shale & Shells
1685-1715	Anhydrite
1715-2400	Shale & Shells
2400-3585	Lime & Shale
3585-3630	Lime
3630-3870	Lime & Shale
3870-3925	Lime
3925-3990	Lime & Shale
3990-4285	Lime
4285-4335	Lime & Chert
4335-4370	Shale & Lime
4370-4505	Lime
4505-4580	Chert
4580-4640	Chert & Lime
4640-4660	Lime
4660-4710	Lime & Chert
4710-4770	Lime Chert Streaks
4770-4895	Lime
4895	T.D.

Hoebner	3828
Lansing	3868
Marmaton	4165
Ft. Scott	4225
Cherokee Sand	4362
Mississippian	4430
Viola	4738
Simpson	4854
Arbuckle	4871

RECEIVED
STATE CORPORATION COMMISSION
APR 2 - 1957
CONSERVATION DIVISION
Kansas

PLUGGING
FILE SEC. 24 T. 17 R. 23W
BOOK PAGE 149 LINE 9

State of Kansas
County of Sedgewick

I, William J. Duckett of the Lewis Drilling Company

upon oath state that the above and foregoing is a true and correct copy of the log of the J. R. Elmore #1 well.

William J. Duckett

Subscribed and sworn to before me this 28th day of March 19 57

My Commission Expires: 8-20-60

A. R. Darrington
(A. R. Darrington) Notary Public