


WELL PLUGGING RECORD

Give All Information Completely
Make Required Affidavit
Mail or Deliver Report to:
Conservation Division
State Corporation Commission
800 Biting Building
Wichita, Kansas

NORTH

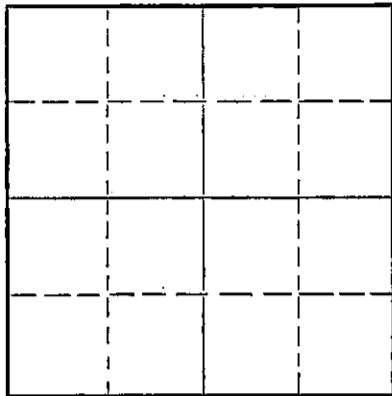

Locate well correctly on above Section Plat

Pawnee County, Sec. 33 Twp. 21S Rge. 16 (E) W.(W)
Location as "NE/CNWSW" or footage from lines App. C W/2 SW/4 SE/4
Lease Owner Hershel Hutchins
Lease Name Seeman Well No. 1
Office Address Sterling, Kansas
Character of Well (completed as Oil, Gas or Dry Hole) Dry Hole
Date well completed Nov. 26 19 53
Application for plugging filed Nov. 26 19 53
Application for plugging approved Nov. 26 19 53
Plugging commenced Nov. 26 19 53
Plugging completed Nov. 26 19 53
Reason for abandonment of well or producing formation Dry Hole

If a producing well is abandoned, date of last production _____ 19 _____
Was permission obtained from the Conservation Division or its agents before plugging was commenced? Yes

Name of Conservation Agent who supervised plugging of this well M. A. Rives
Producing formation _____ Depth to top _____ Bottom _____ Total Depth of Well 3879' Feet
Show depth and thickness of all water, oil and gas formations.

OIL, GAS OR WATER RECORDS

CASING RECORD

| FORMATION | CONTENT | FROM | TO | SIZE | PUT IN | PULLED OUT |
|-----------|---------|------|----|--------|--------|------------|
| | | | | 8-5/8" | 985' | |
| | | | | | | |
| | | | | | | |
| | | | | | | |
| | | | | | | |
| | | | | | | |
| | | | | | | |

Describe in detail the manner in which the well was plugged, indicating where the mud fluid was placed and the method or methods used in introducing it into the hole. If cement or other plugs were used, state the character of same and depth placed, from _____ feet to _____ feet for each plug set.

Filled hole with heavy mud. Layed down drill pipe, cemented with 20 sacks of cement at 300'. Filled surface pipe with mud. Set 10 sacks of cement plug at 40'.

RECEIVED
STATE CORPORATION COMMISSION
WICHITA, KANSAS
12-05-53

(If additional description is necessary, use BACK of this sheet)
Name of Plugging Contractor Group Exploration Company
Address Sterling, Kansas

STATE OF KANSAS, COUNTY OF RICE, ss.
Rollin Mead (employee of owner) or (owner or operator) of the above-described well, being first duly sworn on oath, says: That I have knowledge of the facts, statements, and matters herein contained and the log of the above-described well as filed and that the same are true and correct. So help me God.


(Signature) Rollin Mead
Sterling, Kansas (Address)

SUBSCRIBED AND SWORN TO before me this 26th day of November, 19 53

My Commission Expires Sept. 17, 1957.

My commission expires _____

J. A. [Signature]
Notary Public.

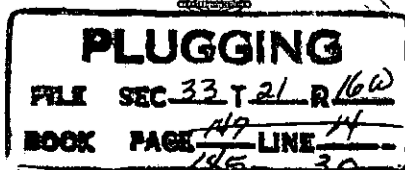

GROUP EXPLORATION CO.

BOX 218
STERLING, KANSAS

WELL LOG----- SEEMAN #1

Location: App. C W/2 SW/4 SE/4 Sec. 33-21S-16W, Pawnee Co., Kansas

OWNER: Hershel Hutchins
ROTARY DRILLING CONTRACTOR: Group Exploration Company
CABLE TOOL CONTRACTOR:

Commenced: 11-12-53 (w.r.)
(w.c.t.)

Completed: 11-26-53 (w.r.)
(w.c.t.)

Total Depth: 3879'

LOG

| | |
|-----------|--------------|
| 0- 90 | Sand |
| 90- 425 | Shale |
| 425- 540 | Sand |
| 540- 980 | Shale |
| 980- 985 | Anhydrite |
| 985-1765 | Shale |
| 1765-2145 | Shale & Lime |
| 2145-2360 | Lime |
| 2360-2845 | Shale & Lime |
| 2845-2930 | Lime |
| 2930-3045 | Shale & Lime |
| 3045-3235 | Lime |
| 3235-3295 | Shale & Lime |
| 3295-3345 | Lime |
| 3345-3485 | Shale & Lime |
| 3485-3498 | Shale |
| 3498-3760 | Lime |
| 3760-3854 | Shale & Lime |
| 3854-3879 | Lime |

CASING RECORD

Ran 985' of 8-5/8" casing,
cemented with 450 sacks of
cement, bulk.

PRODUCTION

Dry and abandoned.

