


STATE OF KANSAS
STATE CORPORATION COMMISSION

WELL PLUGGING RECORD

Give All Information Completely
Make Required Affidavit
Mail or Deliver Report to:
Conservation Division
State Corporation Commission
800 Bittling Building
Wichita, Kansas

Pawnee County, Sec. 33 Twp. 21S Rge. (E) 16W

Location as "NE/CNWxSWx" or footage from lines C SE NE SE
Lease Owner Gulf Oil Corporation
Lease Name Rose Auerbach Well No. 1
Office Address Box 661 Tulsa, Oklahoma
Character of Well (completed as Oil, Gas or Dry Hole) Dry Hole
Date well completed _____ 19____
Application for plugging filed 4-21 1954
Application for plugging approved 4-21 1954
Plugging commenced 4-26 1954
Plugging completed 4-28 1954
Reason for abandonment of well or producing formation Dry Hole

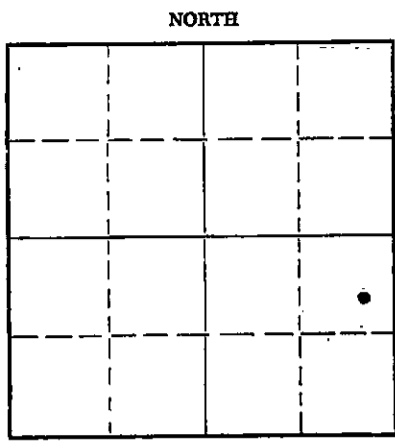

Locate well correctly on above
Section Plat

If a producing well is abandoned, date of last production _____ 19____
Was permission obtained from the Conservation Division or its agents before plugging was commenced? Yes

Name of Conservation Agent who supervised plugging of this well M. A. Rives
Producing formation Arbuckle Depth to top 3855 Bottom 3858 Total Depth of Well PB 3858' Feet
Show depth and thickness of all water, oil and gas formations.

OIL, GAS OR WATER RECORDS

CASING RECORD

| FORMATION | CONTENT | FROM | TO | SIZE | PUT IN | PULLED OUT |
|-----------|---------|------|----|--------|--------|------------|
| | | | | 8-5/8" | 987' | None |
| | | | | 5-1/2" | 3856' | 3276' |
| | | | | | | |
| | | | | | | |
| | | | | | | |
| | | | | | | |
| | | | | | | |
| | | | | | | |

Describe in detail the manner in which the well was plugged, indicating where the mud fluid was placed and the method or methods used in introducing it into the hole. If cement or other plugs were used, state the character of same and depth placed, from _____ feet to _____ feet for each plug set.

Filled hole with sand from 3858' to 3850' and grouted with 5 sacks cement at 3850'. Ripped pipe. Recovered 99 jts. and 3 nipples of 5 1/2" casing. HOWCO mixed and pumped 30 sacks Aquagel into surface pipe, followed by 100 sacks cement which filled hole to bottom of cellar. Final pump pressure 200#. Well P&A.

(If additional description is necessary, use BACK of this sheet)

Name of Plugging Contractor Morgan Well Servicing
Address 102 West 18th St, Hutchinson, Kansas

STATE OF Kansas, COUNTY OF Rice, ss.
W. H. Duley (employee of owner) or (Notary Public) of the above-described well, being first duly sworn on oath, says: That I have knowledge of the facts, statements, and matters herein contained and the log of the above-described well as filed and that the same are true and correct. So help me God.

(Signature) W. H. Duley
Box 544 Chase, Kansas
(Address)

SUBSCRIBED AND SWORN TO before me this 6th day of May, 1954

My commission expires April 14, 1956

W. H. Council Notary Public.
RECEIVED
STATE CORPORATION COMMISSION
MAY 7 - 1954
CONSERVATION DIVISION
Wichita, Kansas

24-7368-8 3-53-20M
PLUGGING
FILE SEC 33 T 21 R 16W
BOOK PAGE 26 LINE 26

WELL NO. 1 LEASE Rose Anserbach COMPANY Gulf Oil Corporation A.F.E. 3262
 DATE-DRILLING BEGAN 3-20-54 WELL COMPLETED 4-28-54 FIRST PRODUCTION
 SAND RECORD Dry Hole - Plugged and Abandoned TOTAL DEPTH 3858'
 P.S. from 3862'

INITIAL PRODUCTION

CASING RECORD

| SIZE | WEIGHT | THD. | CLASS | MAKE | SET AT DEPTH | SACKS CEMENT | LBS. CAL. CHLG. | PULLED | LEFT IN |
|-----------------------------------|--------|------|-------|------|--------------|--------------|-----------------|--------|----------|
| 8-5/8" | 10 | SR | A | SS | 987' | 430 | | | 987' |
| 5-1/2" | 14 | SR | A | SS | 3856 1/2' | 100 | | 3276' | 580 1/2' |
| * 3 jts - 32' - 10V - G1 C-1 - SS | | | | | | | | | |
| 23 jts - 23' - 1V - G1 A - 1V | | | | | | | | | |

S= 33 T= 21S R= 16T

| | | | |
|---------|--|--|--|
| Center | | | |
| SE | | | |
| NS | | | |
| SW | | | |
| Parish | | | |
| County, | | | |
| Kansas | | | |

Distance H - 8' from EOB to top 8-5/8" csg collar

ELEVATION- 1990'

Filled hole w/sand 3858-3850' - spotted 5 sacks cement 3850'
 Ripped 5-1/2" csg at 3230, 3200, 3170' - 4-28-54

FORMATION RECORD

| | From | To |
|---------------------|------|------|
| Sand & clay | 0 | 120 |
| Shale | | 134 |
| Sand | | 501 |
| Red bed | | 939 |
| Anhydrite | | 1013 |
| Red bed & shale | | 1235 |
| Shale & shells | | 1940 |
| Shale & lime | | 2125 |
| Lime | | 2225 |
| Lime & shale | | 2595 |
| Shale & lime shells | | 2695 |
| Shale | | 2840 |
| Shale & lime | | 3125 |
| Lime | | 3375 |
| Lime & shale | | 3455 |
| Shale & lime | | 3530 |
| Lime | | 3725 |
| Lime & chert | | 3780 |
| Lime & shale | | 3840 |
| Shale | | 3855 |
| Lime | | 3862 |
| T.D. | | 3862 |

Hdbjc

PLUGGING
 FILE SEP 33 24 1/6w
 BOOK PAGE 26 LINE 26

RECEIVED
 STATE REGISTRATION COMMISSION
 JUN 9 1954
 RESERVATION DIVISION
 Wichita, Kansas