


WELL PLUGGING RECORD

Give All Information Completely
Make Required Affidavit
Mail or Delivered Report to:
Conservation Division
State Corporation Commission
211 No. Broadway
Wichita, Kansas

Ness County, Sec. 12 Twp. 18S Rge. 21 (E) (W)
Location as "NE/CNW/SW" or footage from lines NW NE SE
Lease Owner R. W. Shields
Lease Name Elmore "B" Well No. 1
Office Address Rule Building, Wichita 2, Kansas
Character of Well (completed as Oil, Gas or Dry Hole) Dry Hole
Date well completed 11/1 1959
Application for plugging filed 11/1 1959
Application for plugging approved 11/1 1959
Plugging commenced 11/1 1959
Plugging completed 11/1 1959
Reason for abandonment of well or producing formation Dry Hole

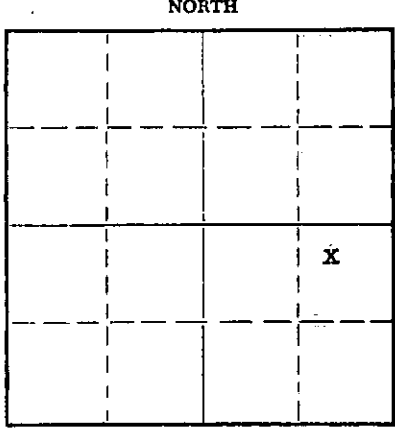

Locate well correctly on above Section Plat

If a producing well is abandoned, date of last production -- 19
Was permission obtained from the Conservation Division or its agents before plugging was commenced? Yes

Name of Conservation Agent who supervised plugging of this well Eldon Petty
Producing formation _____ Depth to top _____ Bottom _____ Total Depth of Well 4210 Feet
Show depth and thickness of all water, oil and gas formations.

OIL, GAS OR WATER RECORDS

CASING RECORD

FORMATION	CONTENT	FROM	TO	SIZE	PUT IN	PULLED OUT

Describe in detail the manner in which the well was plugged, indicating where the mud fluid was placed and the method or methods used in introducing it into the hole. If cement or other plugs were used, state the character of same and depth placed, from _____ feet to _____ feet for each plug set.
Set first plug @ 600 feet with 20 sacks cement on top. Set another plug @ 270 feet with 20 sacks cement on top. Set third plug @ 40 feet using 1/2 sack hulls and 10 sacks cement to bottom of cellar.

RECEIVED
STATE CORPORATION COMMISSION
NOV 4 1959
11-4-59
CONSERVATION DIVISION
Wichita, Kansas

(If additional description is necessary, use BACK of this sheet)
Name of Plugging Contractor Barnett Drilling, Inc.
Address 409 First National Bank Building, Wichita 2, Kansas

STATE OF Kansas, COUNTY OF Sedgwick
Jack S. Griggs, employee of contractor (employee or owner) or (owner or operator) of the above-described well, being first duly sworn on oath, says: That I have knowledge of the facts, statements, and matters herein contained and the log of the above-described well as filed and that the same are true and correct. So help me God.

(Signature) Jack S. Griggs
409 First National Bank Building, Wichita, Ks.
(Address)

SUBSCRIBED AND SWORN TO before me this 3rd day of November 1959

Louise K. Whitted
Louise K. Whitted Notary Public.

My commission expires November 26, 1962

15135-60078-0000

BARNETT DRILLING, INC.
WELL LOG
EIMORE "B" NO: 1
NW 1/4 SE, SEC. 12-185-21W
NESS COUNTY, KANSAS.

DATE ROTARY COMMENCED: 10/21/59

DATE ROTARY COMPLETED: 11/1/59

Formation	From	To
Surface Clay	0	40
Sand & Shale	40	60
Shale & Shells	60	278
Sand	278	380
Shale & Shells	380	800
Sand & Shale	800	1020
Shale & Shell	1020	1200
Shale & Red Bed	1200	1364
Anhydrite	1364	1395
Shale & Shell	1395	1900
Shale & Lime Shell	1900	2130
Lime	2130	2850
Lime & Shale	2850	2735
Lime	2735	3950
Lime & Shale	3950	4000
Lime	4000	4210 Total Depth

RECEIVED
STATE CORPORATION COMMISSION
NOV 4 1959
CONSERVATION DIVISION
Wichita, Kansas

Set 278' of 8-5/8" Surface Casing, Cemented with 175 sacks cement.