


Give All Information Completely  
Make Required Affidavit  
Mail or Deliver Report to:  
Conservation Division  
State Corporation Commission  
800 Bittig Building  
Wichita, Kansas

WELL PLUGGING RECORD

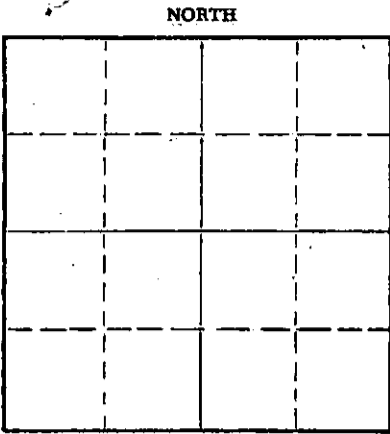

Ness County. Sec. 11 Twp. 18S Rge.        (E) 21 (W)  
Location as "NE/CNWxSWx" or footage from lines C-SW-SW-SE  
Lease Owner Sunray Mid-Continent Oil Company  
Lease Name Janke Well No. 1  
Office Address Box # 788, Great Bend, Kansas  
Character of Well (completed as Oil, Gas or Dry Hole) Dry Hole  
Date well completed May 4, 1956  
Application for plugging filed May 4, 1956  
Application for plugging approved May 5, 1956  
Plugging commenced May 4, 1956  
Plugging completed May 4, 1956  
Reason for abandonment of well or producing formation       

If a producing well is abandoned, date of last production 19  
Was permission obtained from the Conservation Division or its agents before plugging was commenced? yes

Name of Conservation Agent who supervised plugging of this well R. M. Brundage  
Producing formation        Depth to top        Bottom        Total Depth of Well 4620 Feet  
Show depth and thickness of all water, oil and gas formations.

OIL, GAS OR WATER RECORDS

CASING RECORD

FORMATION	CONTENT	FROM	TO	SIZE	PUT IN	PULLED OUT
				8 5/8"	302'	None

Describe in detail the manner in which the well was plugged, indicating where the mud fluid was placed and the method or methods used in introducing it into the hole. If cement or other plugs were used, state the character of same and depth placed, from        feet to        feet for each plug set.

Filled hole with heavy drilling mud to 300', pushed 1/3 sacks hulls and Halliburton wooden plug to 300', displaced 35 sacks cement on top of plug. Filled hole with heavy drlg. mud to 35', pushed 1/3 sack hull and Halliburton wooden plug to 35', displaced 10 sacks cement on top of plug. Cement to surface. Plugging completed.

(If additional description is necessary, use BACK of this sheet)

Name of Plugging Contractor         
Address       

STATE OF KANSAS, COUNTY OF BARTON, ss.  
Norman E. Montgomery (employee of owner) or (~~owner~~) of the above-described well, being first duly sworn on oath, says: That I have knowledge of the facts, statements, and matters herein contained and the log of the above-described well as filed and that the same are true and correct. So help me God.

(Signature) Norman E. Montgomery  
Box # 788, Great Bend, Kansas  
(Address)

SUBSCRIBED AND SWORN TO before me this 10 day of May, 19 56

W. A. L. L.

RECEIVED  
STATE CORPORATION COMMISSION

Notary Public.

My commission expires Dec. 24, 1956

MAY 11 1956  
5-11-56  
PLUGGING  
CONSERVATION DIVISION  
Wichita, Kansas  
BOOK PAGE 59 LINE 15  
FILED SEC 11 T 18 R 21W

Sunray Mid-Continent Oil Company  
Tulsa, Oklahoma

15135 00068 0000  
Tulsa, Oklahoma  
May 8, 1956

CONTRACTOR: Stickle Drilling Company  
Drilling Commenced: April 12, 1956  
Drilling Completed: May 4, 1956

Janke #1 - SW SW SE  
Section 11-18S-21W,  
Ness County, Kansas

DRILLERS LOG

Depth Figures Indicate Base of Formation

Clay, Shale & Sand	120
Shale	302
Shale, Shells, & Sand Streaks	680
Red Bed Shale & Shells	920
Sand	1050
Sand & Red Bed	1120
Shale & Shells	1415
Anhydrite	1450
Shale & Shells	2185
Shale & Lime	2325
Lime & Shale	2480
Lime	2615
Lime Sandy	2655
Lime & Shale	3680
Lime	3710
Lime	4140
Shale & Sand	4170
Sand & Shale	4198
Sand & Shale	4223
Sand, Shale & Chert	4255
Lime & Chert	4302
Chert	4318
Lime & Chert	4335
Lime	4439
Lime w/Chert	4495
Lime	4559
Lime & Shale	4574
Sand & Shale	4583
Lime	4595
Arbuckle Dolomite	4620 TD

I, Frank E. Stickle, hereby certify the above to be a true and complete Drillers Log of Sunray Mid-Continent Oil Company's Janke #1 - SW SW SE of Section 11-18S-21W, Ness County, Kansas.

Frank E. Stickle  
Frank E. Stickle

Lillian T. Bonham  
Notary Public

February 13, 1960  
My Commission Expires

**PLUGGING**  
FILE SEC 11 T 18 R 21W  
BOOK PAGE 59 LINE 15

RECEIVED  
MAY 11 1956  
CONSERVATION DIVISION  
WARRANTS SECTION