


WELL PLUGGING RECORD

Give All Information Completely
Make Required Affidavit
Mail or Deliver Report to:
Conservation Division
State Corporation Commission
212 No. Market
Wichita, Kansas

Kingman County, Sec. 2 Twp. 30S Rge. 9 (E) W (W)

Location as "NE/CNWXSWK" or footage from lines. C NW SW
Lease Owner **Sierra Petroleum Co., Inc.**
Lease Name **Whitmer-Swingle** Well No. **1**
Office Address **211 N. Broadway, Wichita, Kansas**
Character of Well (completed as Oil, Gas or Dry Hole) **Dry Hole**
Date well completed **4-5 1967**
Application for plugging filed **4-5 1967**
Application for plugging approved **4-5 1967**
Plugging commenced **4-5 1967**
Plugging completed **4-5 1967**
Reason for abandonment of well or producing formation **Dry Hole**

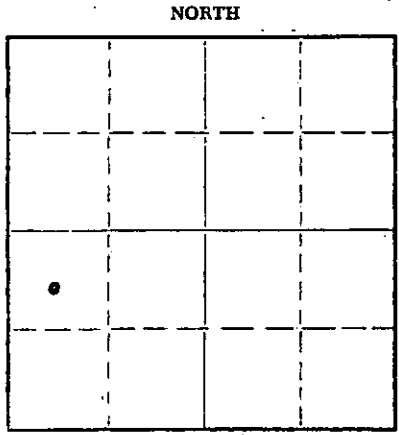

Locate well correctly on above Section Plat

If a producing well is abandoned, date of last production **19**
Was permission obtained from the Conservation Division or its agents before plugging was commenced? **Yes**

Name of Conservation Agent who supervised plugging of this well **Archie Elving**
Producing formation _____ Depth to top _____ Bottom _____ Total Depth of Well _____ Feet
Show depth and thickness of all water, oil and gas formations.

OIL, GAS OR WATER RECORDS CASING RECORD

FORMATION	CONTENT	FROM	TO	SIZE	PUT IN	PULLED OUT
Surface Pipe		-0-	241	8 5/8	241	None

Describe in detail the manner in which the well was plugged, indicating where the mud fluid was placed and the method or methods used in introducing it into the hole. If cement or other plugs were used, state the character of same and depth placed, from _____ feet to _____ feet for each plug set.

Filled hole with heavy mud.
#1 plug @225' with 25 sks. cement 1/2 sk. hulls
#2 plug @ 40' with 11 sks cement 1/2 sk. hulls
#3 plug in rat hole with 2 sks. cement

RECEIVED
State Corporation Commission
APR 19 1967
4-10-67
CONSERVATION DIVISION
Wichita, Kansas

(If additional description is necessary, use BACK of this sheet)
Name of Plugging Contractor **S & S Drilling Co.**
Address **Box 645, Great Bend, Kansas 67530**

STATE OF Kansas COUNTY OF Barton, ss.
T. D. Sweetman (employee of owner) or (owner or operator) of the above-described well, being first duly sworn on oath, says: That I have knowledge of the facts, statements, and matters herein contained and the log of the above-described well as filed and that the same are true and correct. So help me God.

(Signature) T. D. Sweetman
Box 645, Great Bend, Kansas 67530
(Address)

SUBSCRIBED AND SWORN TO before me this 7th day of April, 19 67

My commission expires 5-9-67
Heata L Boyd Notary Public.

WELL LOG
Whitmer-Swingle #1
C NW SW 2-30S-9W
Kingman County, Kansas

Elevation: 1629' K.B.

<u>FROM</u>	<u>TO</u>	
0	40	Clay
40	65	Sand
65	1650	Redbed & Shale
1650	3660	Shale & Lime
3660	3730	Lime
3730	3843	Lime & Shale
3843	4260	Lime
4260		Total Depth

RECEIVED
STATE CORPORATION COMMISSION
APR 19 1967
CONSERVATION DIVISION
Wichita, Kansas

STATE OF KANSAS
COUNTY OF BARTON ss

T. D. Sweetman, Partner of S & S Drilling Company, being first duly sworn on oath says: That I have knowledge of the facts, statements and matters herein contained and the log of the above described well as filed and that the same are true and correct.

T. D. Sweetman
T. D. Sweetman

Subscribed and sworn before me this 7th day of April, 1967

Leata L. Boyd
Notary Public Barton County

My Commission Expires 5/9/67