


15735-22268-0000

WELL PLUGGING RECORD

Give All Information Completely
 Make Required Affidavit

COUNTY Ness SEC. 8 TWP. 18S RGE. 21W E/W
 Location as in quarters or footage from lines:
C SW SW

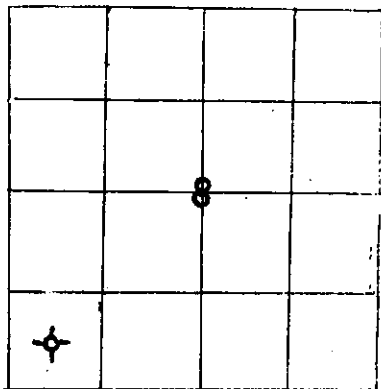

Locate Well
 correctly on above
 Section Platt.

Lease Owner Bird Energy, Inc.
 Lease Name Fritz Well No. 1
 Office Address Box 1612, Dodge City, KS 67801
 Character of Well (Completed as Oil, Gas or Dry Hole): Dry Hole
 Date Well Completed 8-10-82
 Application for plugging filed 8-10-82
 Plugging commenced 8-09-82
 Plugging completed 8-10-82
 Reason for abandonment of well or producing formation _____

Was permission obtained from the Conservation Division or it's
 Agent's before plugging was commenced? yes

Name of Conservation Agent who supervised plugging of this well Gil Balthazor

Producing formation _____ Depth to top _____ bottom _____ T.D. 4335

Show depth and thickness of all water, oil and gas formations.

OIL, GAS OR WATER RECORDS

Casing Record

Formation	Content	From	To	Size	Put in	Pulled Out
Surface	shale	0	331	8-5/8"	327	none
	cemented with 275	sx 60/40 pos		2%gel, 3% cc		
	plug down at 11:15 p.m	8-2-82		by Sun.		
	cement did circ.					

Describe in detail the manner in which the well was plugged, indicating where the mud fluid was placed and the method or methods used in introducing it into the hold. If cement or other plugs were used, state the character of same and depth placed, from _____ feet to _____ feet for each plug set.

Plugged with 50/50 posmix, 4%gel, 3% cc, as follows:

70 sx @ 580'

40 sx @ 340'

10 sx @ 40'

10 sx in rat hole; job completed at 2:45 a.m. by Sun 8-10-82

(If additional description is necessary, use BACK of this sheet)


Name of Plugging Contractor J. W. Drilling Co., Inc.

STATE OF KANSAS COUNTY OF SEDGWICK, ss.

Jon T. Williams, Jr. (employee of owner) or (owner or operator) of the above-described well, being first duly sworn on oath, says: That I have knowledge of the facts, statements, and matters herein contained and the log of the above-described well as filed and that the same are true and correct. So help me God.

(Signature)

200 E. First, Suite 500, Wichita, KS
 (Address)

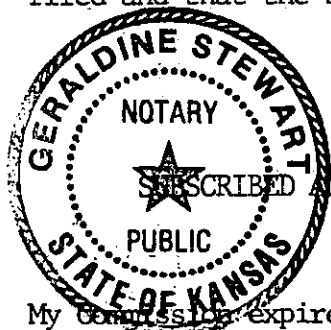

SUBSCRIBED AND SWORN TO before me this 10th day of August, 19 82

Geraldine Stewart
 Geraldine Stewart, Notary Public.

My Commission Expires: January 14, 1985

RECEIVED
 AUG 19 1982
 8-19-82
 CONSERVATION DIVISION
 Wichita, Kansas