


WELL PLUGGING RECORD

15-135-21469-0000

Give All Information Completely
Make Required Affidavit
Mail or Deliver Report to
Conservation Division
State Corporation Comm.
245 North Water
Wichita, KS 67202

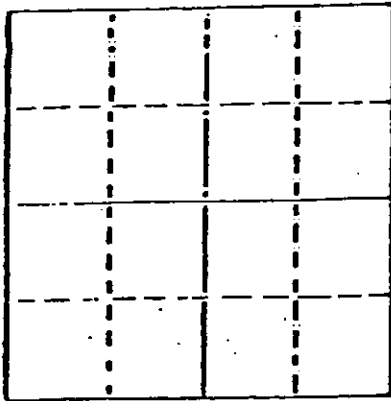

Locate well correctly on above
Section Plat

Ness County, Sec. 32 Twp. 16S Rge. 26W E/W
Location as "NE/CNW $\frac{1}{4}$ SW $\frac{1}{4}$ " or footage from lines
NE NE

Lease Owner PICKRELL DRILLING COMPANY
Lease Name HORCHEM "N" Well No. 2
Office Address 205 LITWIN BLDG., WICHITA, KS. 67202
Character of Well (Completed as Oil, Gas or Dry Hole)
Dry Hole

Date Well completed 6-10-78 19
Application for plugging filed 6-10-78 19
Application for plugging approved 6-10-78 19
Plugging commenced 6-10-78 19
Plugging completed 6-10-78 19
Reason for abandonment of well or producing formation
Dry Hole

If a producing well is abandoned, date of last production
19

Was permission obtained from the Conservation Division or
its agents before plugging was commenced? Yes

Name of Conservation Agent who supervised plugging of this well Clarence Thomas
Producing formation Depth to top Bottom Total Depth of Well 4610
Show depth and thickness of all water, oil and gas formations.

OIL, GAS OR WATER RECORDS

CASING RECORD

FORMATION	CONTENT	FROM	TO	SIZE	PUT IN	PULLED OUT
				8 5/8	211	None

Describe in detail the manner in which the well was plugged, indicating where the mud fluid
was placed and the method or methods used in introducing it into the hold. If cement or other
plugs were used, state the character of same and depth placed, from feet to
feet for each plug set.

RECEIVED
STATE CORPORATION COMMISSION
JUL 14 1978
7-14-78
CONSERVATION DIVISION
Wichita, Kansas

70 sacks at 600'
20 sacks at 200'
10 sacks at 40'
5 sacks in Rat Hole Plug down @ 12:30AM 6/10/78

(If additional description is necessary, use BACK of this sheet)

Name of Plugging Contractor Pickrell Drilling Company

STATE OF Kansas COUNTY OF Sedgwick, ss.
C. W. Sebitts (employee of owner) or (owner or operator)

I, the above-described well, being first duly sworn on oath, says: That I have knowledge of
the facts, statements, and matters herein contained and the log of the above-described well
is filed and that the same are true and correct. So help me God. BY: C. W. Sebitts

(Signature)

205 Litwin Bldg., Wichita, Ks. 67202
(Address)

SUBSCRIBED AND SWORN TO before me this 19 day of June, 1978

commission expires



Jo Ann Sarver
Notary Public.

ROTARY DRILLING LOG

15-135-21469-0000

COMPANY: PICKRELL DRILLING COMPANY
205 LITWIN BLDG.
WICHITA, KS. 67202
LOCATION: HORCHEM "N" #2
NE NE Sec. 32-16S-26W
Ness Co., Kansas
CONTRACTOR: PICKRELL DRILLING COMPANY
Wichita, Kansas

Rotary Drilling Commenced 6-3-78
Rotary Drilling Completed 6-10-78

CASING RECORD: Surface casing set of 8 5/8" set at 211' with 150sx. PD 12:30PM 6-3-78

LOG

(Figures indicate bottom of formation — measurements from top of rotary bushing.)

Top Soil & Clay	20
Post Rock	35
Shale	214
Shale	450
Shale & Shells	1453
Blaine	1467
Shale	1545
Sand	1765
Shale	2033
Shale	2043
Shale	2079
Shale	2410
Shale & Lime	2620
Shale & Lime	2775
Shale & Lime	2975
Lime & Shale	3145
Shale & Lime	3320
Lime & Shale	3490
Lime & Shale	3645
Lime & Shale	3830
Shale & Lime	3975
Lime	4090
Lime & Shale	4235
Shale & Lime	4335
Lime & Shale	4420
Lime & Shale	4510
Shale & Lime	4568
Shale & Lime	4610

RECEIVED
STATE CORPORATION COMMISSION
JUL 14 1978
CONSERVATION DIVISION
Wichita, Kansas

The undersigned, C. W. Sebitts, Attorney-in-Fact for PICKRELL DRILLING COMPANY, hereby certifies in behalf of said Company, that the above is a true and correct log of the formation encountered in drilling the above well as reflected by the Daily Drilling Reports.

PICKRELL DRILLING COMPANY

By [Signature]
Attorney-in-Fact
C. W. Sebitts

STATE OF KANSAS }
COUNTY OF SEDGWICK } ss.:

On this 19 day of June, 19 78, before me the undersigned, a Notary Public, in and for the County and State aforesaid, personally appeared C. W. Sebitts,

to me known to be the identical person who subscribed the name of PICKRELL DRILLING COMPANY to the foregoing instrument as its Attorney-in-Fact and acknowledged to me that he executed the same as his free and voluntary act and deed, and as the free and voluntary act and deed of such company, for the uses and purposes therein set forth.

Given under my hand and seal of office the day and year last above written.

My commission expires:



[Signature]
Notary Public

Jo Ann Sarver