


STATE OF KANSAS
STATE CORPORATION COMMISSION

WELL PLUGGING RECORD

Give All Information Completely
Make Required Affidavit
Mail or Deliver Report to
Conservation Division
State Corporation Comm.
245 North Water
Wichita, KS 67202

Ness County, Sec. 31 Twp. 16S Rge. 26 ~~EXW~~
Location as "NE/CNW $\frac{1}{4}$ SW $\frac{1}{4}$ " or footage from lines _____
W/2 SW NE
Lease Owner Kansas Oil Corporation
Lease Name Lundgren Well No. 1
Office Address 400 N. Woodlawn, Suite 2
Character of Well (Completed as Oil, Gas or Dry Hole) _____

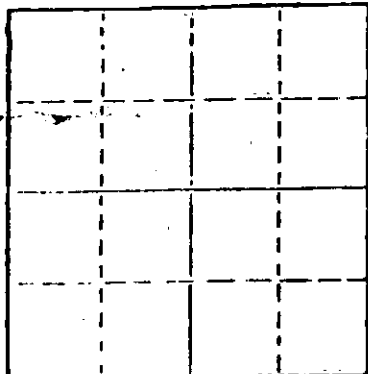

Locate well correctly on above
Section Plot

dry hole
Date Well completed 8-3 1979
Application for plugging filed 8-3 1979
Application for plugging approved 8-3 1979
Plugging commenced 8-3 1979
Plugging completed 8-3 1979
Reason for abandonment of well or producing formation
no commercial quantities of oil or gas encountered
If a producing well is abandoned, date of last production
-- 19

Name of Conservation Agent who supervised plugging of this well Marion Schmidt
Producing formation _____ Depth to top _____ Bottom _____ Total Depth of Well 4720
Show depth and thickness of all water, oil and gas formations.

OIL, GAS OR WATER RECORDS

CASING RECORD

FORMATION	CONTENT	FROM	TO	SIZE	PUT IN	PULLED OUT
surface Hole	shale	surf	328'	8-5/8"	321'	none

Describe in detail the manner in which the well was plugged, indicating where the mud fluid was placed and the method or methods used in introducing it into the hold. If cement or other plugs were used, state the character of same and depth placed, from _____ feet to _____ feet for each plug set.

Fluid to 855', plug, 70 sx
Fluid to 320', plug, 20 sx
Fluid to 40', plug, 10 sx
Rat hole 3 sx

RECEIVED
STATE CORPORATION COMMISSION
AUG 14 1979
8-14-79
CONSERVATION DIVISION
Wichita, Kansas

(If additional description is necessary, use BACK of this sheet)

Name of Plugging Contractor D N B DRILLING, INC.
515 R. H. Garvey Building
Wichita, Kansas 67202

STATE OF Kansas COUNTY OF Sedgwick, ss.
Ella Priess (employee of owner) or (owner or operator)
of the above-described well, being first duly sworn on oath, says: That I have knowledge of the facts, statements, and matters herein contained and the log of the above-described well as filed and that the same are true and correct. So help me God.

(Signature) Ella Priess
515 R.H. Garvey Bldg., Wichita, Ks. 67202
(Address)

SUBSCRIBED AND SWORN TO before me this 6th day of August, 19 79

My commission expires April 30, 1983

Dorothy L. Schmidt
Dorothy L. Schmidt Notary Public.

DOROTHY L. SCHMIDT
STATE NOTARY PUBLIC
Sedgwick County, Kansas
My Appt. Exp. April 30, 1983

15-135-21665-0000

DRILLER'S LOG

KANSAS OIL CORPORATION
No. 1 Lundgren
W/2 SW NE Sec 31-16S-26W
Ness Co., Ks.

Commenced: 7-27-79
Completed: 8-3-79

Surface Casing: 321' of 8-5/8"
cmtd w/ 215 sx common, 2% gel
3% cc

FORMATION

DEPTH

Surface Hole	0 - 328
Shale	328 - 1070
Shale & Sand	1070 - 1930
Shale	1930 - 2510
Lime & Shale	2510 - 3060
Lime	3060 - 3325
LIME & Shale	3325 - 4020
Lime	4020 - 4720 RTD

I do hereby certify that the foregoing statements are true and correct to the best of my knowledge and belief.

D N B DRILLING, INC.

Ella Priess

Ella Priess

STATE OF KANSAS: ss:

Subscribed and sworn to before me this 6th day of August, 1979.

Dorothy L. Schmidt

Dorothy L. Schmidt, Notary Public

RECEIVED
STATE CORPORATION COMMISSION

AUG 14 1979

STATE CORPORATION COMMISSION
Wichita, Kansas

DOROTHY L. SCHMIDT
STATE NOTARY PUBLIC
Sedgwick County, Kansas
My App. Exp. April 30, 1983