


STATE OF KANSAS
STATE CORPORATION COMMISSION

WELL PLUGGING RECORD

Give All Information Completely
Make Required Affidavit
Mail or Deliver Report to
Conservation Division
State Corporation Comm.
245 North Water
Wichita, KS 67202

Ness County. Sec. 30 Twp. 16S Rge. 26W E/W
Location as "NE/CNW/SW" or footage from lines
C SW SW

Lease Owner Buttonwood Petroleum Inc.
Lease Name Jennings Well No. 1-A
Office Address E. 4th Street Suite 605 Tulsa, Okla. 74103
Character of Well (Completed as Oil, Gas or Dry Hole)

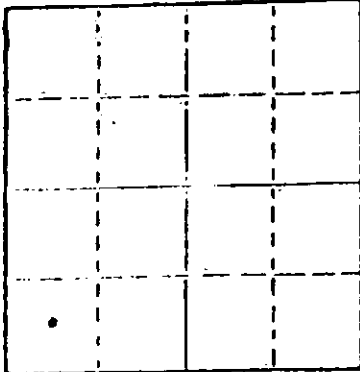

Locate well correctly on above
Section Plot

Dry Hole
Date Well completed 9-26-80 19
Application for plugging filed 9-26-80 19
Application for plugging approved 9-26-80 19
Plugging commenced 8-26-80 19
Plugging completed 9-26-80 19
Reason for abandonment of well or producing formation

If a producing well is abandoned, date of last production 19

Was permission obtained from the Conservation Division or its agents before plugging was commenced? Yes

Name of Conservation Agent who supervised plugging of this well Schmidt
Producing formation Depth to top Bottom Total Depth of Well 4703'
Show depth and thickness of all water, oil and gas formations.

OIL, GAS OR WATER RECORDS

CASING RECORD

FORMATION	CONTENT	FROM	TO	SIZE	PUT IN	PULLED OUT

Describe in detail the manner in which the well was plugged, indicating where the mud fluid was placed and the method or methods used in introducing it into the hold. If cement or other plugs were used, state the character of same and depth placed, from feet to feet for each plug set.

Mud To 1270' 70 Sacks 50-50 Posmix 6% Gel
Mud To 330' 25 Sacks 50-50 Posmix 6% Gel
Mud To 40' 10 Sacks 50-50 Posmix 6% Gel
3 Sacks In Rat Hole
2 Sacks In Mouse Hole

(If additional description is necessary, use BACK of this sheet)

Name of Plugging Contractor Merckle Drilling Co.

STATE OF Kansas COUNTY OF Barton, ss.
Clyde Merckle (employee of owner) or (owner or operator)

of the above-described well, being first duly sworn on oath, says: that I have knowledge of the facts, statements, and matters herein contained and the log of the above-described well as filed and that the same are true and correct. So help me God.

(Signature)

Clyde Merckle
Box 1382 Great Bend, Kansas 67530
(Address)

SUBSCRIBED AND SWORN TO before me this 3rd day of October, 1980

Loretta Bang
Notary Public.

My commission expires 3-28-84



15-135-21874-0000

Buttonwood Petroleum Inc.
9 E. 4th Street Suite 605
Tulsa, Oklahoma 74103

Jennings #1-A

C SW SW
Ness County

Section 30 Twp 16S Rge. 26W

Driller's Log _____ Total Depth 4703'

0-----342 Post Rock & Shale

342----1600 Shale & Shells

1600---1845 Sand

1845---2610 Shale & Lime

2610---3010 Lime & Shale

3010--3515 Lime & Shale

3515---3805 Lime & Shale

3805---4145 Lime

4145---4390 Lime

4390---4703 Lime

Clyde Merckle
Clyde Merckle